


River

---

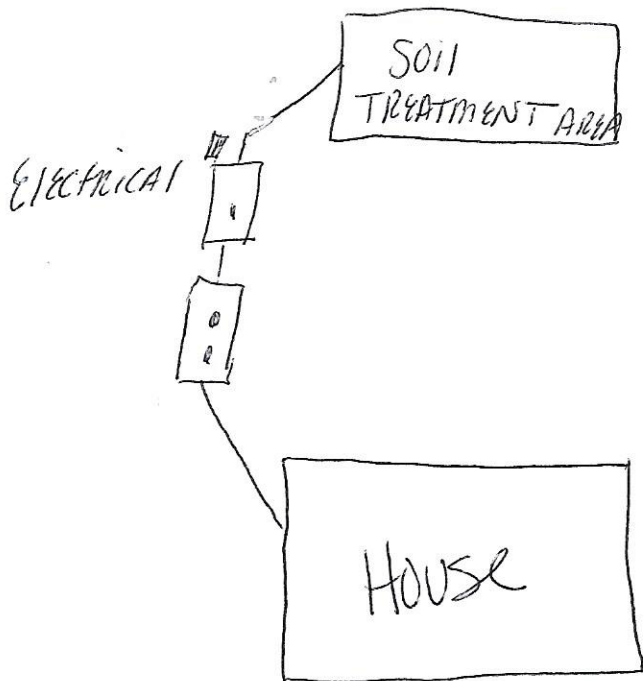

Replacement System 1999