


8285 113RD STREET COTTAGE GROVE, MN

APN

NO SCALE

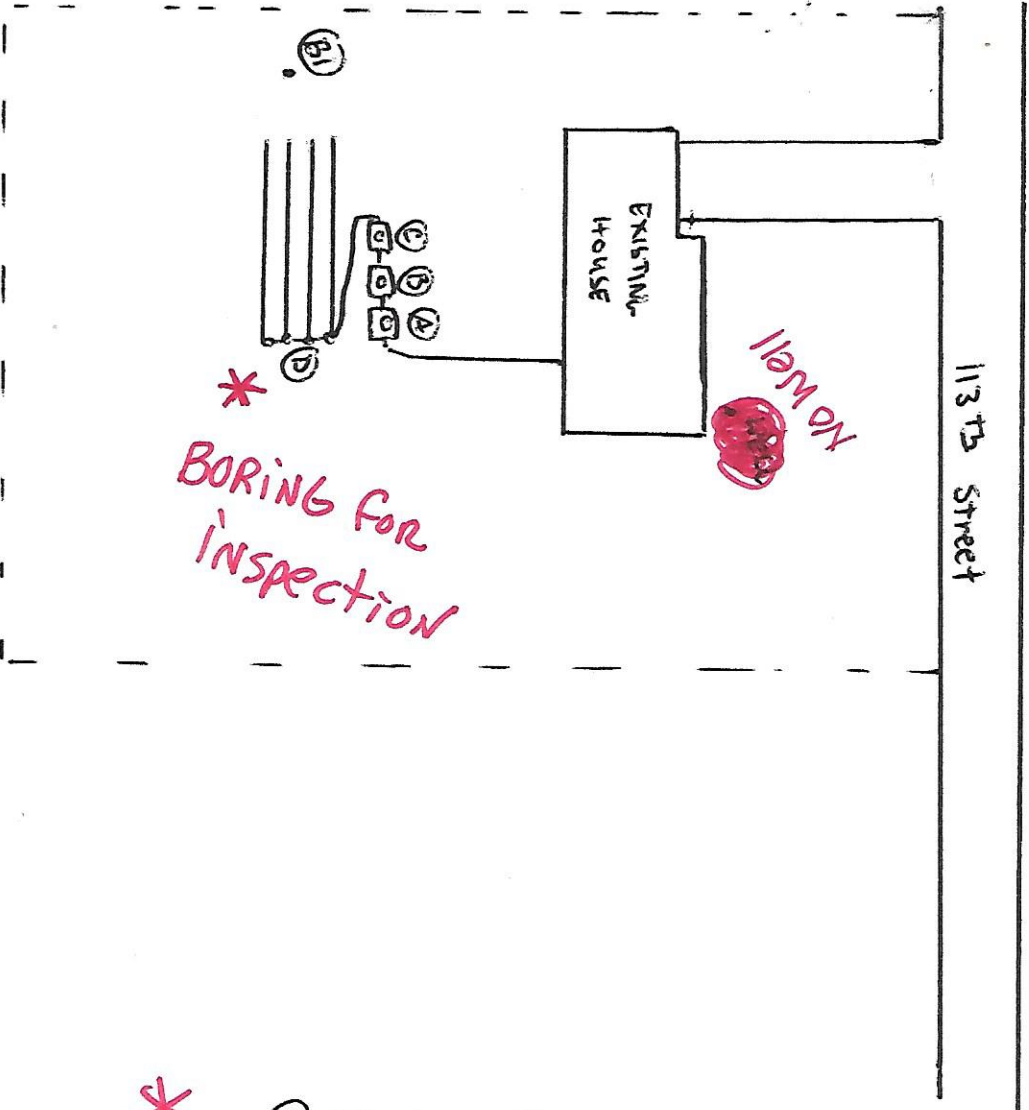

* 2021 BORINGS
for inspection

0-28" 10 9/2 4/4

28-60" 10 9/2 4/3

M&D SANDS