

Compliance Boring Log

Date: 7/9/2021

Property Address: 19841 Jeffrey Circle N, Forest Lake MN 55025

Property Owner name: Dan Neinstadt

Boring 1		Location:		
Soil Horizons Depth	Color	Texture	Structure	Consistence
0-30"	10yr 5/4	Fine Loamy Sand	Friable	Weak
30-60"	10yr 5/3	Fine Loamy Sand	Friable	Weak


Boring 2		Location:		
Soil Horizons Depth	Color	Texture	Structure	Consistence
			Friable	Weak
			Friable	Weak

THIS IS NOT A SURVEY

DATE: 7/9/21

19841 JEFFREY CIRCLE N FOREST LAKE MN

B1

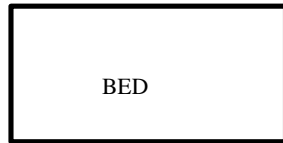

1000 LIFT TANK




1000 MAIN TANK



1500 2 COMP TANK

10'

80'

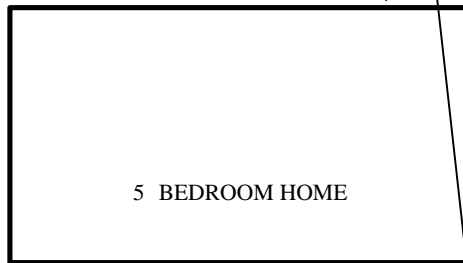

5 BEDROOM HOME

X DEEP WELL

N

