


17 BAILLON LN.

WOODS

Fence - Very Wooded Lot

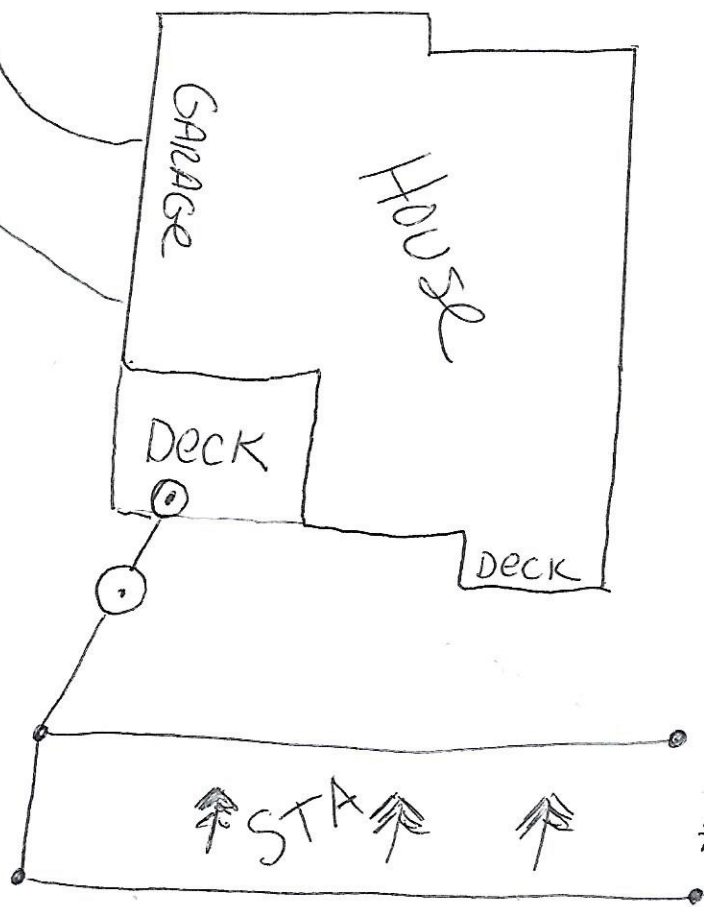

WOODS

* SOIL BORING