


TANKS ARE ALL  
LOW PROFILE

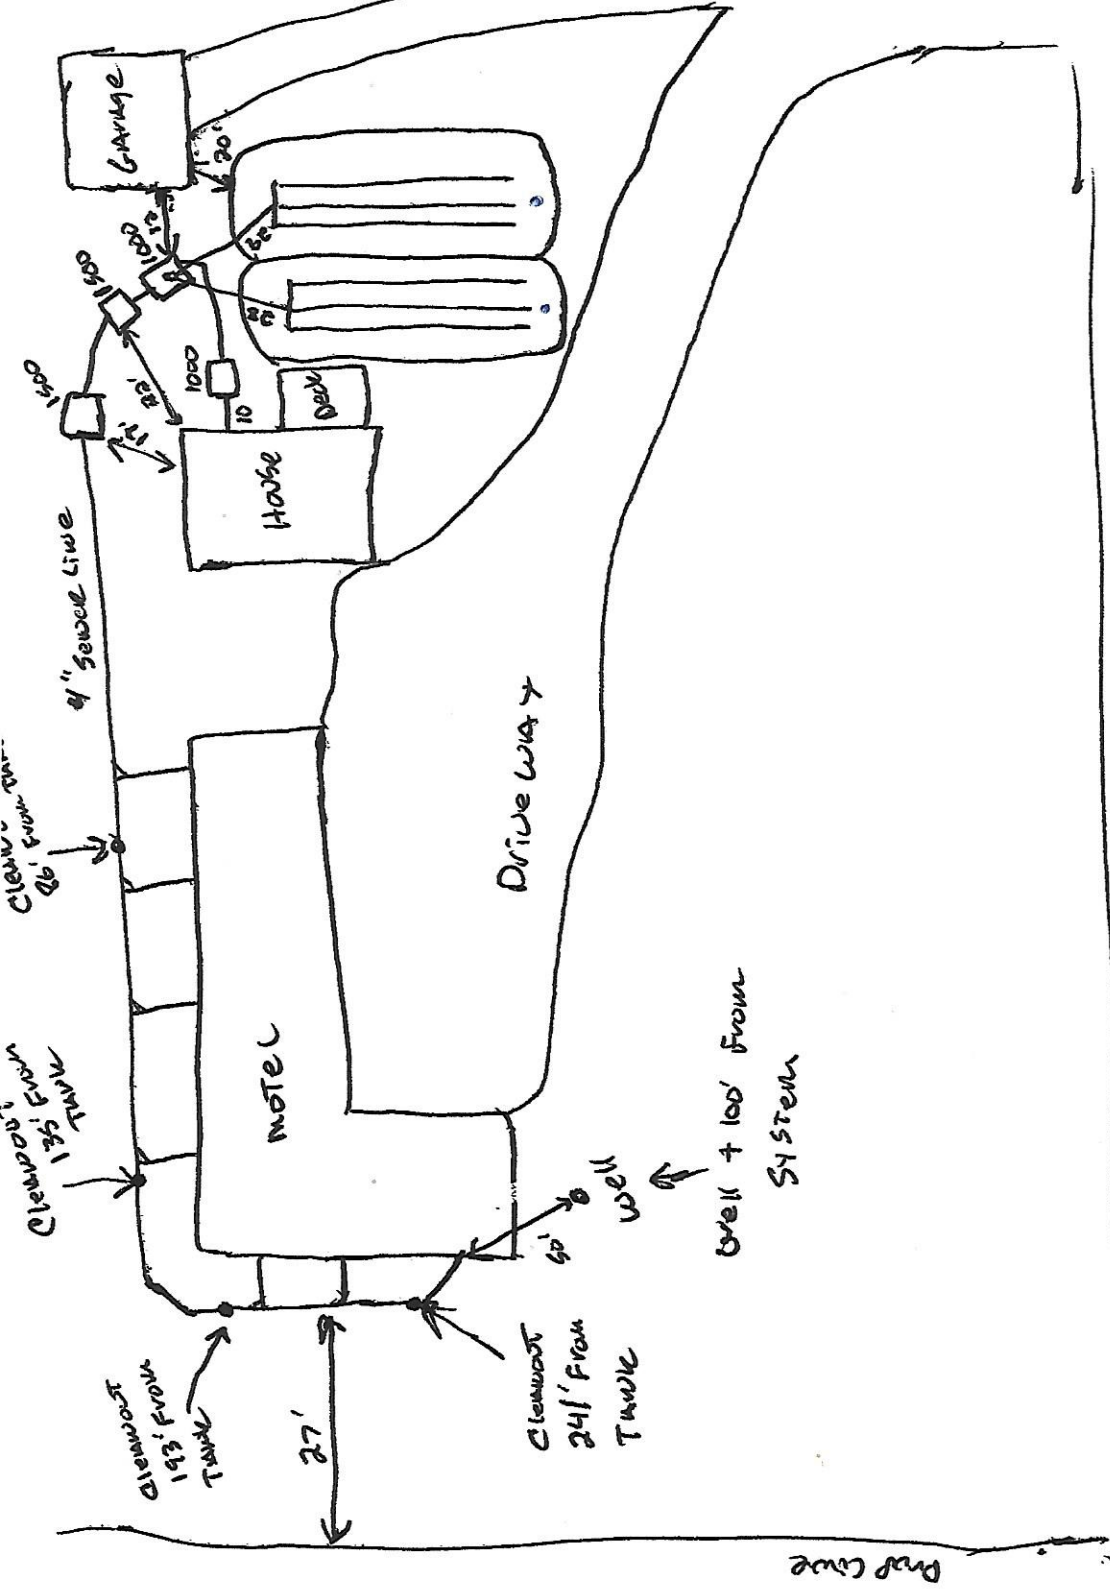

19  
Hwy 61