


150 SQ.FT.
DRAINFIELD

*
SOIL BORING



500 GALLON
SEPTIC TANK

A-C: 27FT
A-D: 51FT
B-C: 33FT
B-D: 40FT

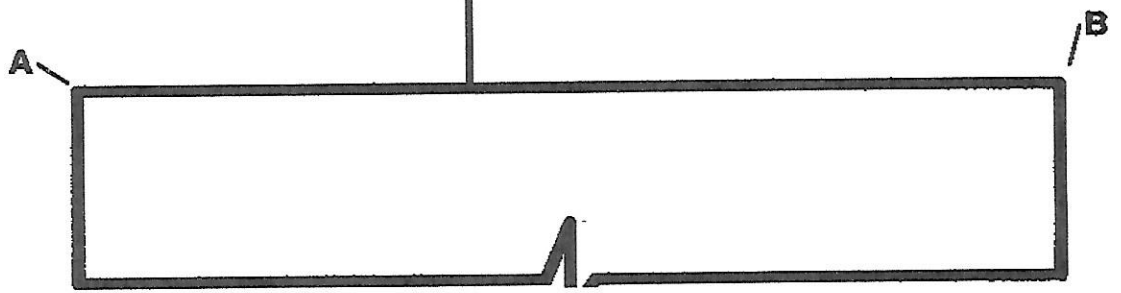

TO
STREET