


fence

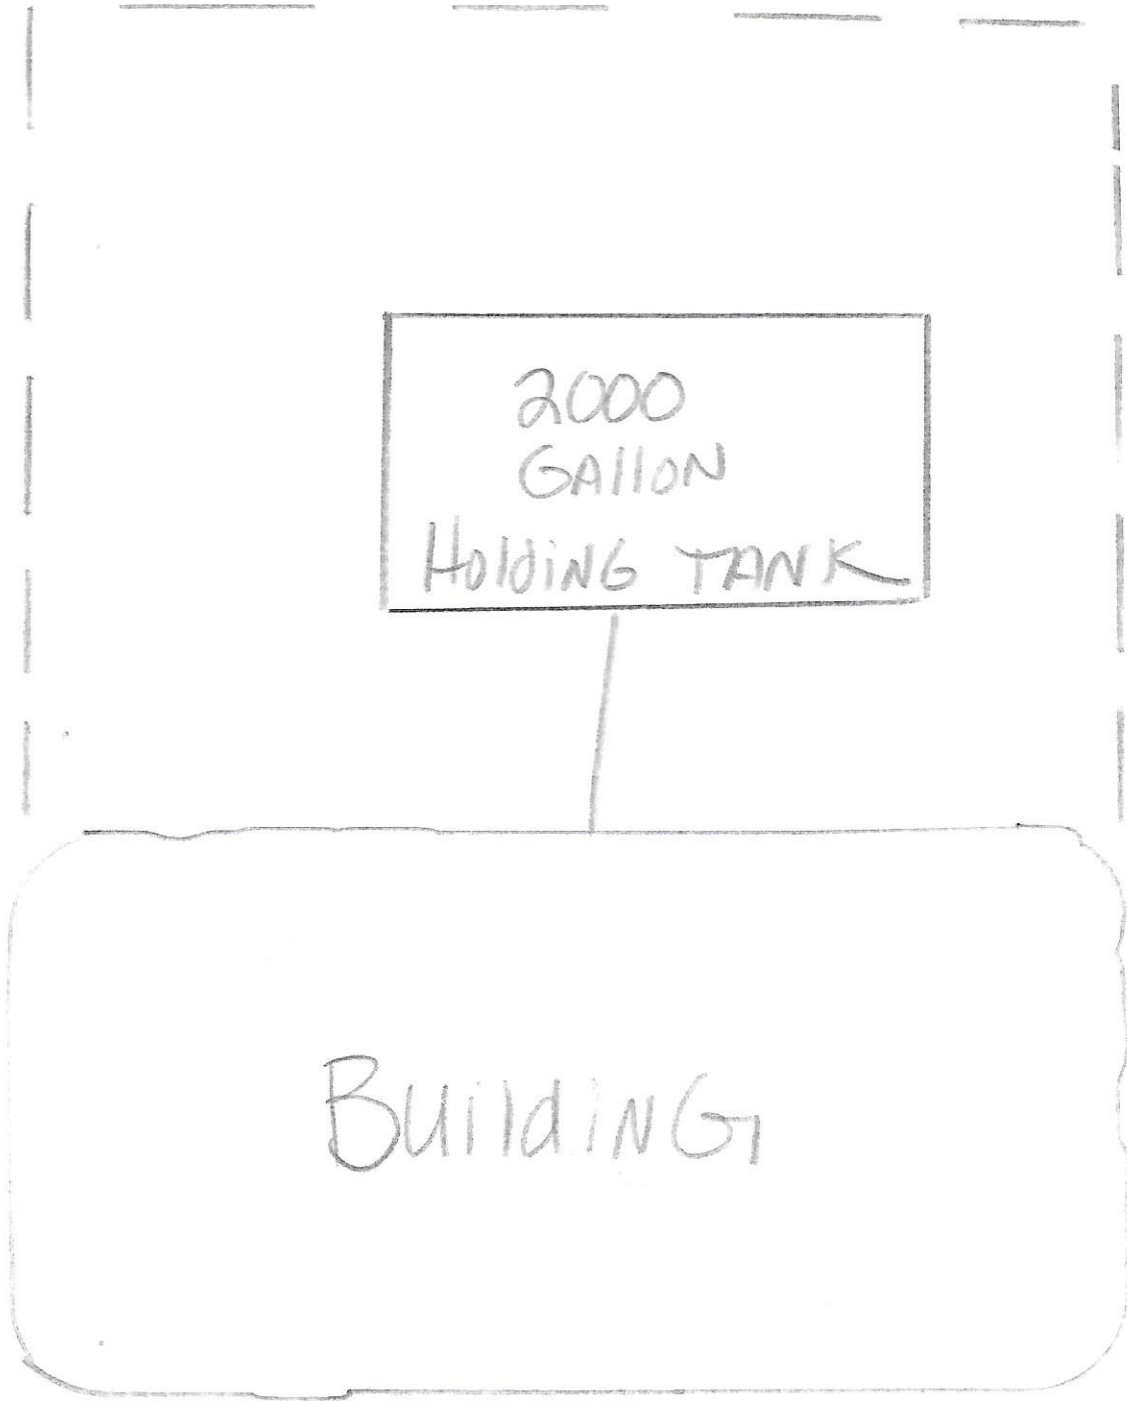

7404 LAMAR AVE