


Custom One Home

4250 Paris Ave
Bay Town Twp

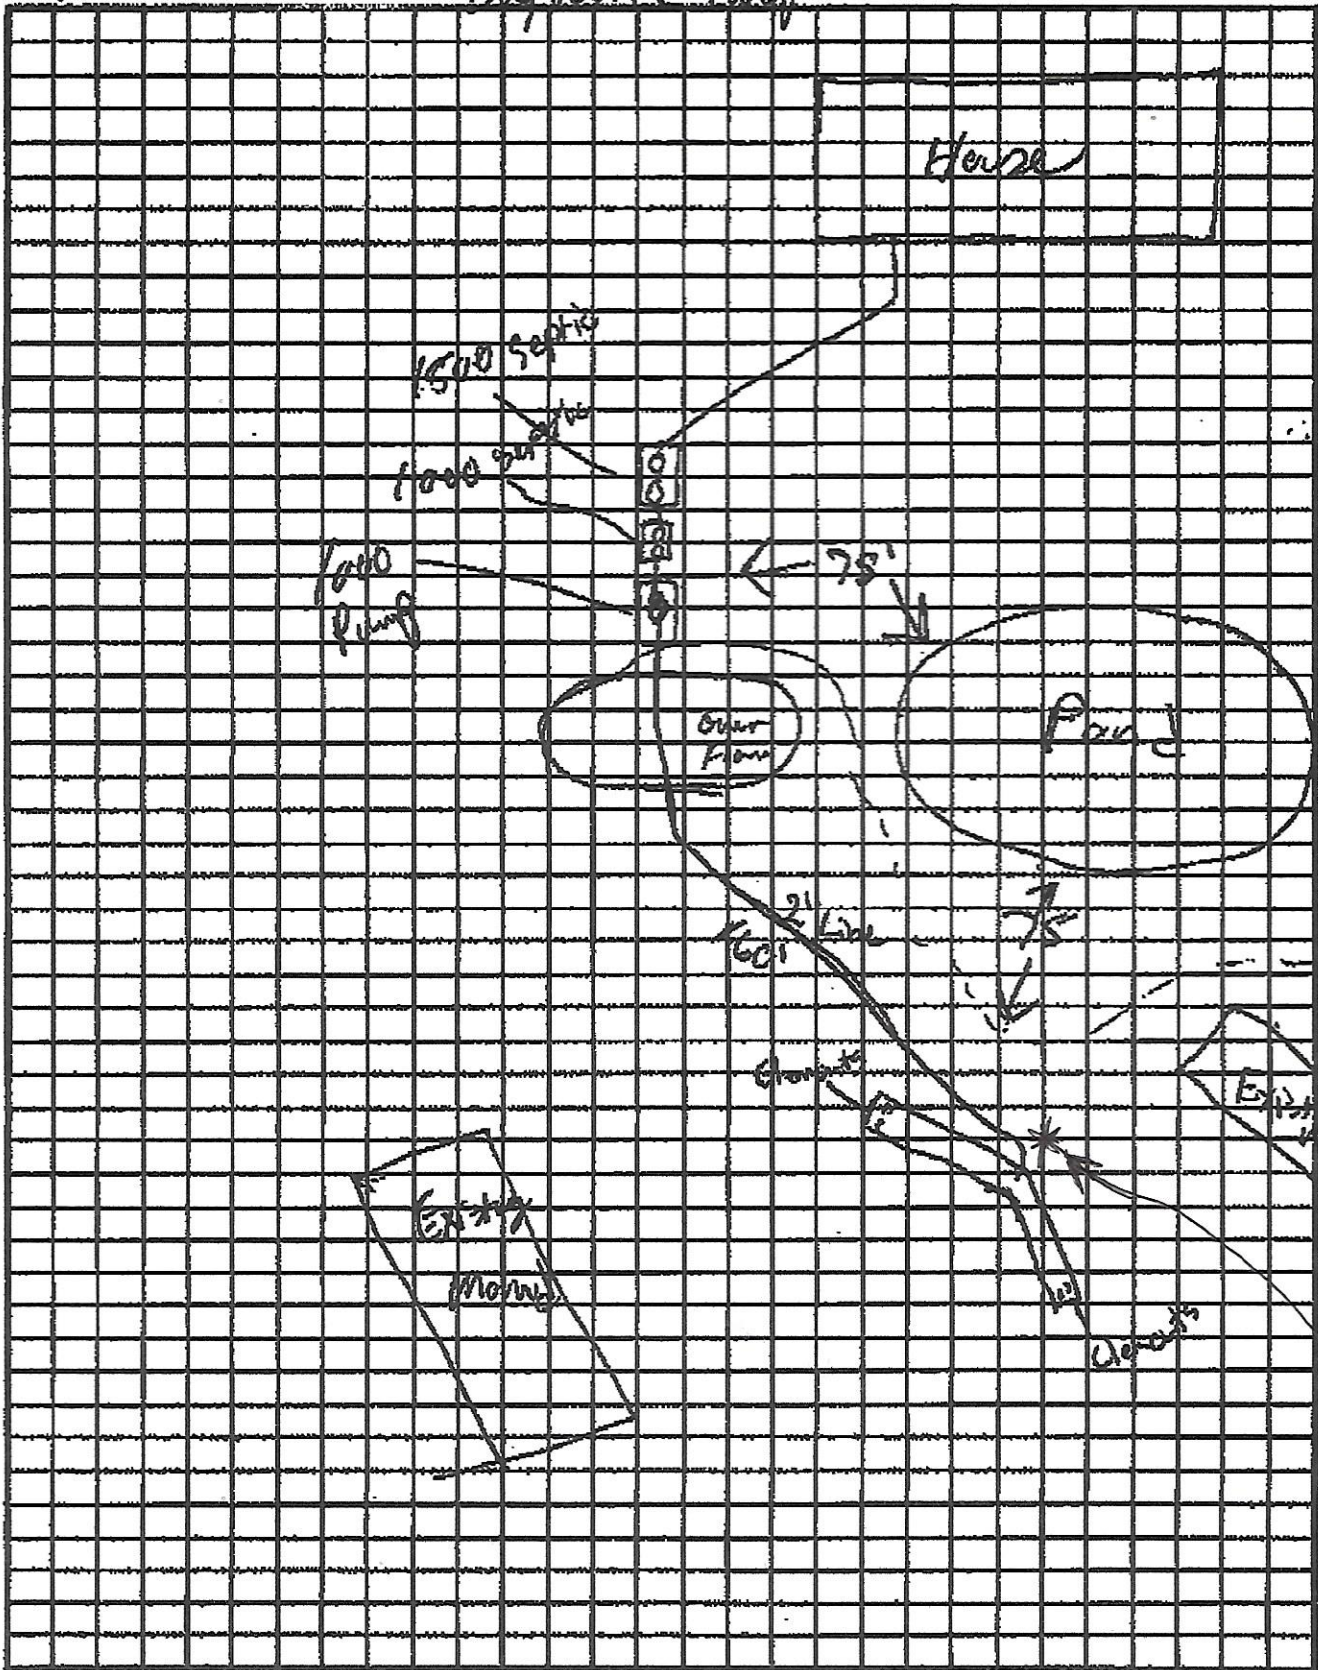

SOIL BORINGS