


7380 LAMAR AVE
GARAGE GROVE

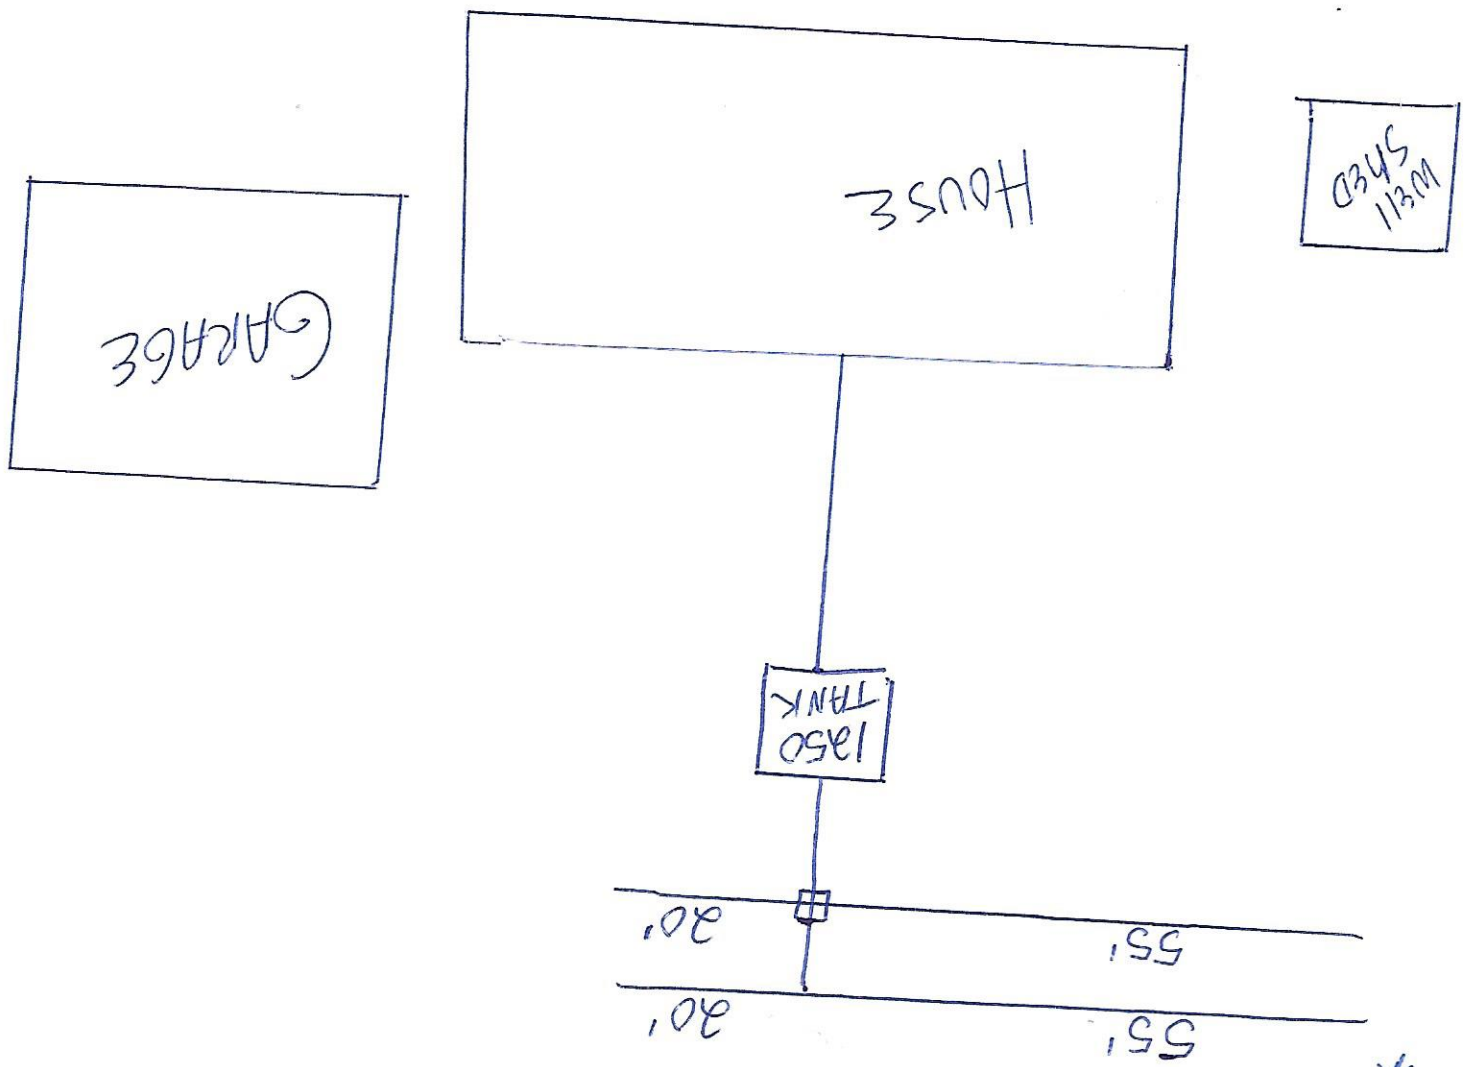

*
SOIL
BORING