


LAKE
McDONALD

POOL

GARAGE

HOUSE

DRIVEWAY

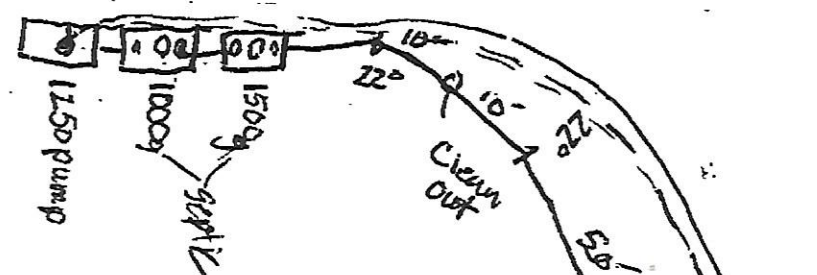

Well
750' to tanks
100' to brain cells

Fence

Electrical
450'


227' pump line 2"

Drop Boxes
7 out

83 chamber
High capacity Infiltrator
6.33/ch 525.39'

**SOIL
BORING**

+ 9 22° Angle
13.5'

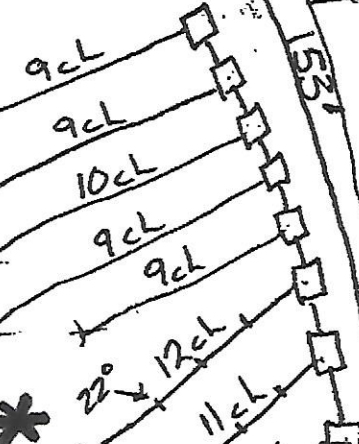

Driveway