

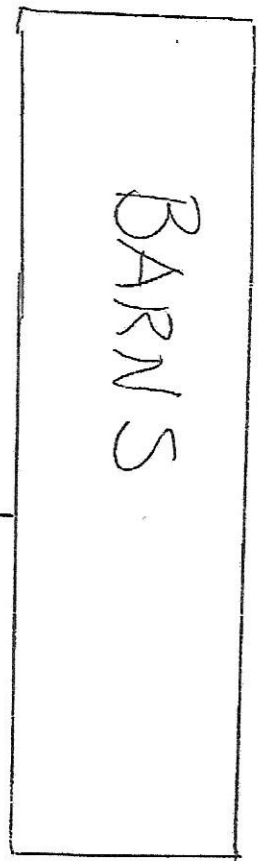
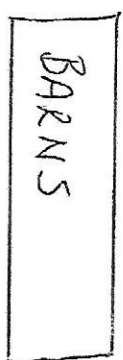


NOT TO SCALE

System #1
1976 system

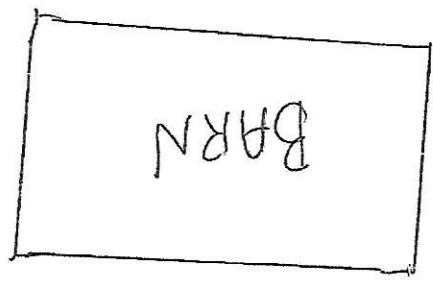


Holdings TANK
System #3

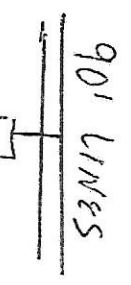

* Soil BORING



1992
System #2

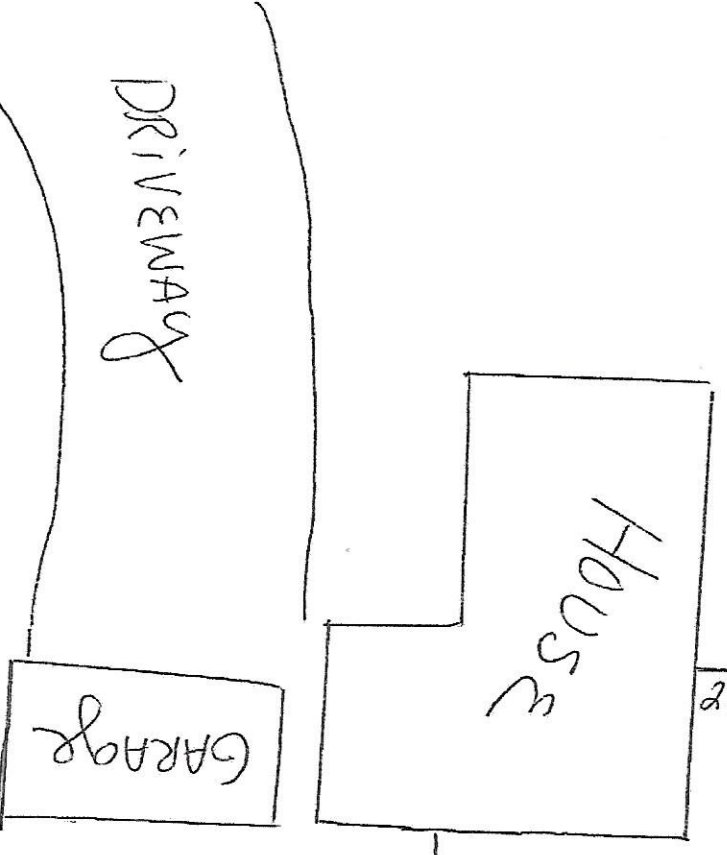

DRIVEWAY

House

GARAGE