



Well *

DRIVEWAY

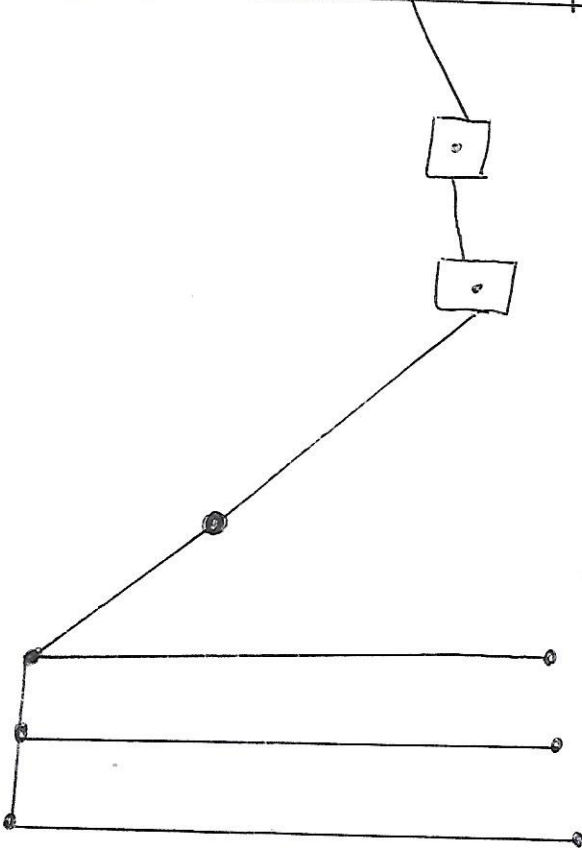

* SOIL BORING

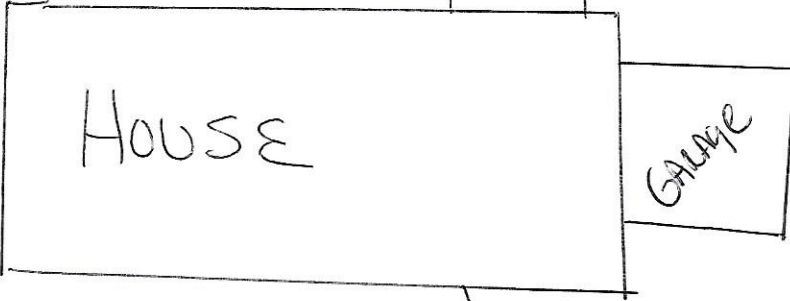