
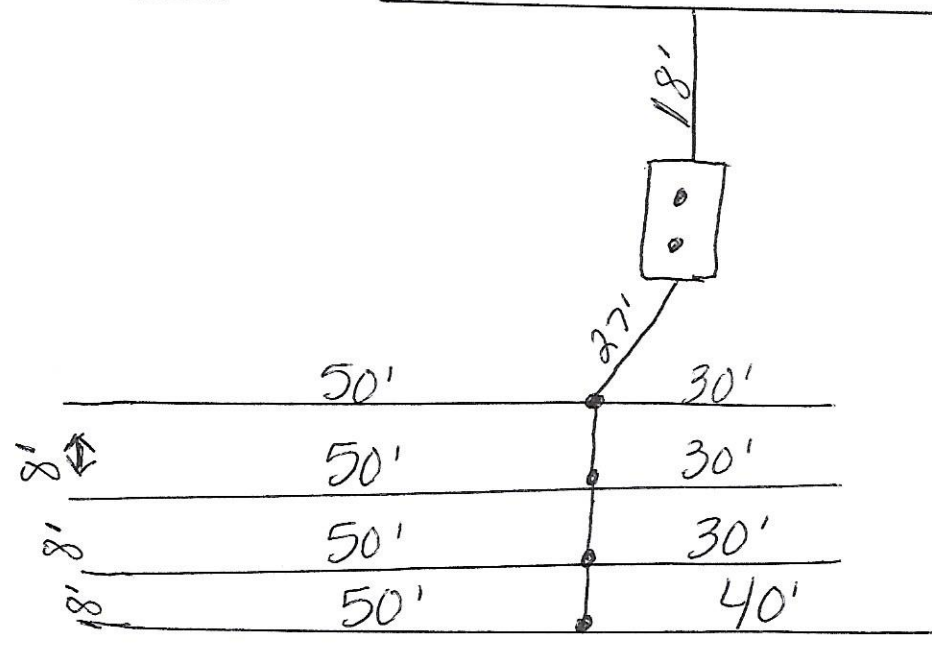


OAKHILL Rd N

SCANDIA

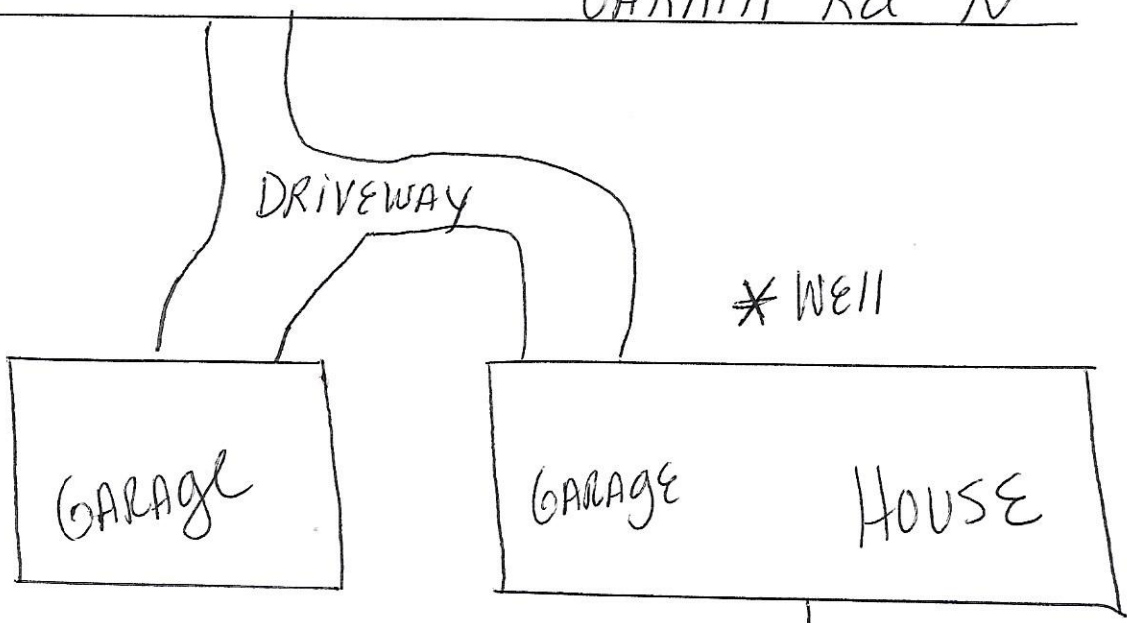

\*  
Soil  
BORING