


PAUL MORLOCK  
 13161 MAYCREST AVE. CT. 50.  
 HASTINGS, MN 55033

PERMIT # 2016-0263




>125'

GRAVEL DRIVEWAY

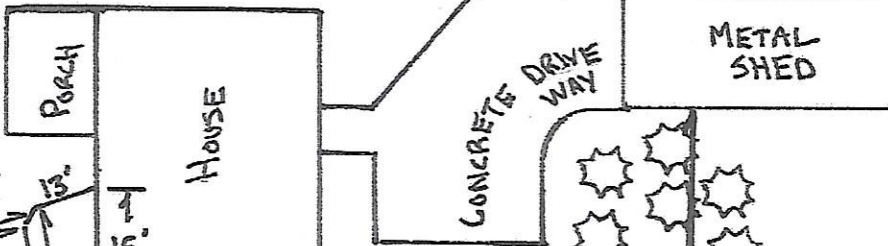

45° & 22 1/2°  
 BEND

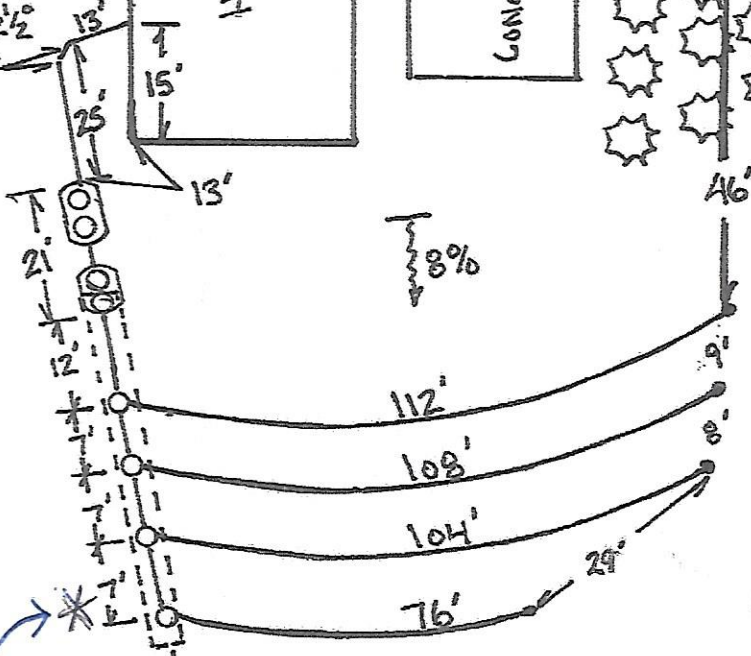

>50'

SOIL BORING

2" x 2" ZSIB INSULATION BOARD OVER SUPPLY LINE AND DROP BOXES

NOTE: METAL MARKERS NEXT TO DROP BOX AND INSPECTION PIPES FOR FUTURE LOCATING

>50'

PROPERTY LINE

>50'  
 PROPERTY LINE