


11497 120th ST. S
DENMARK TWP.

COMPLETED 6/18/03

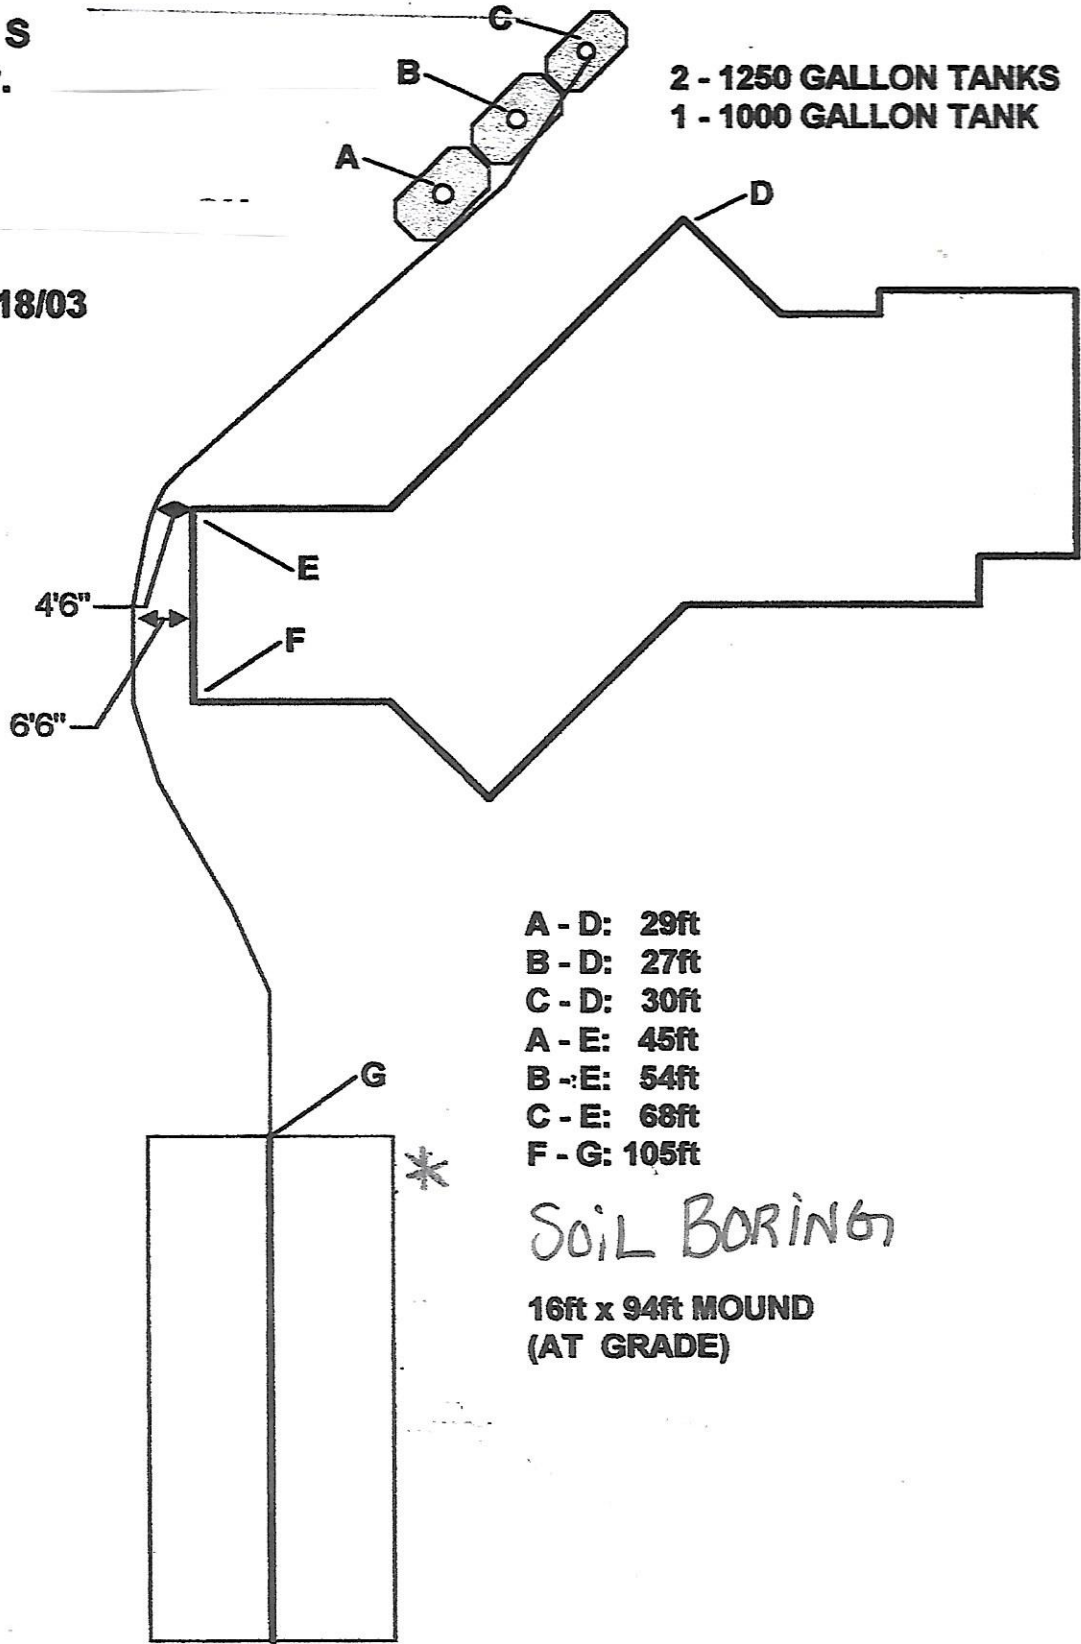

SHARED WELL