


B-2




NORTH

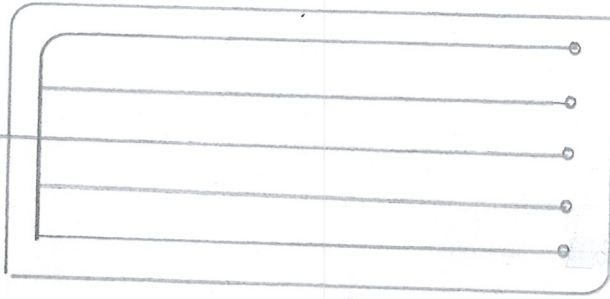


↑
PRESSURE BED
DRAINFIELD

⊗
B-1

2" PUMPLINE

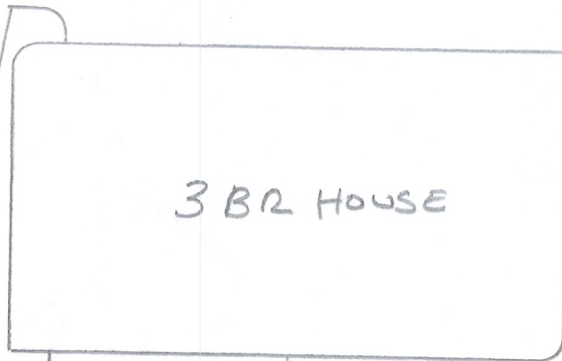

3 BR HOUSE

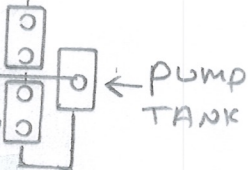

← PUMP
TANK

SEPTIC
TANKS

CITY WATER

53 QUEHL AVES
LAKELAND, MN 55093
10/16/21