


4389 PASTURE RIDGE Rd Afton

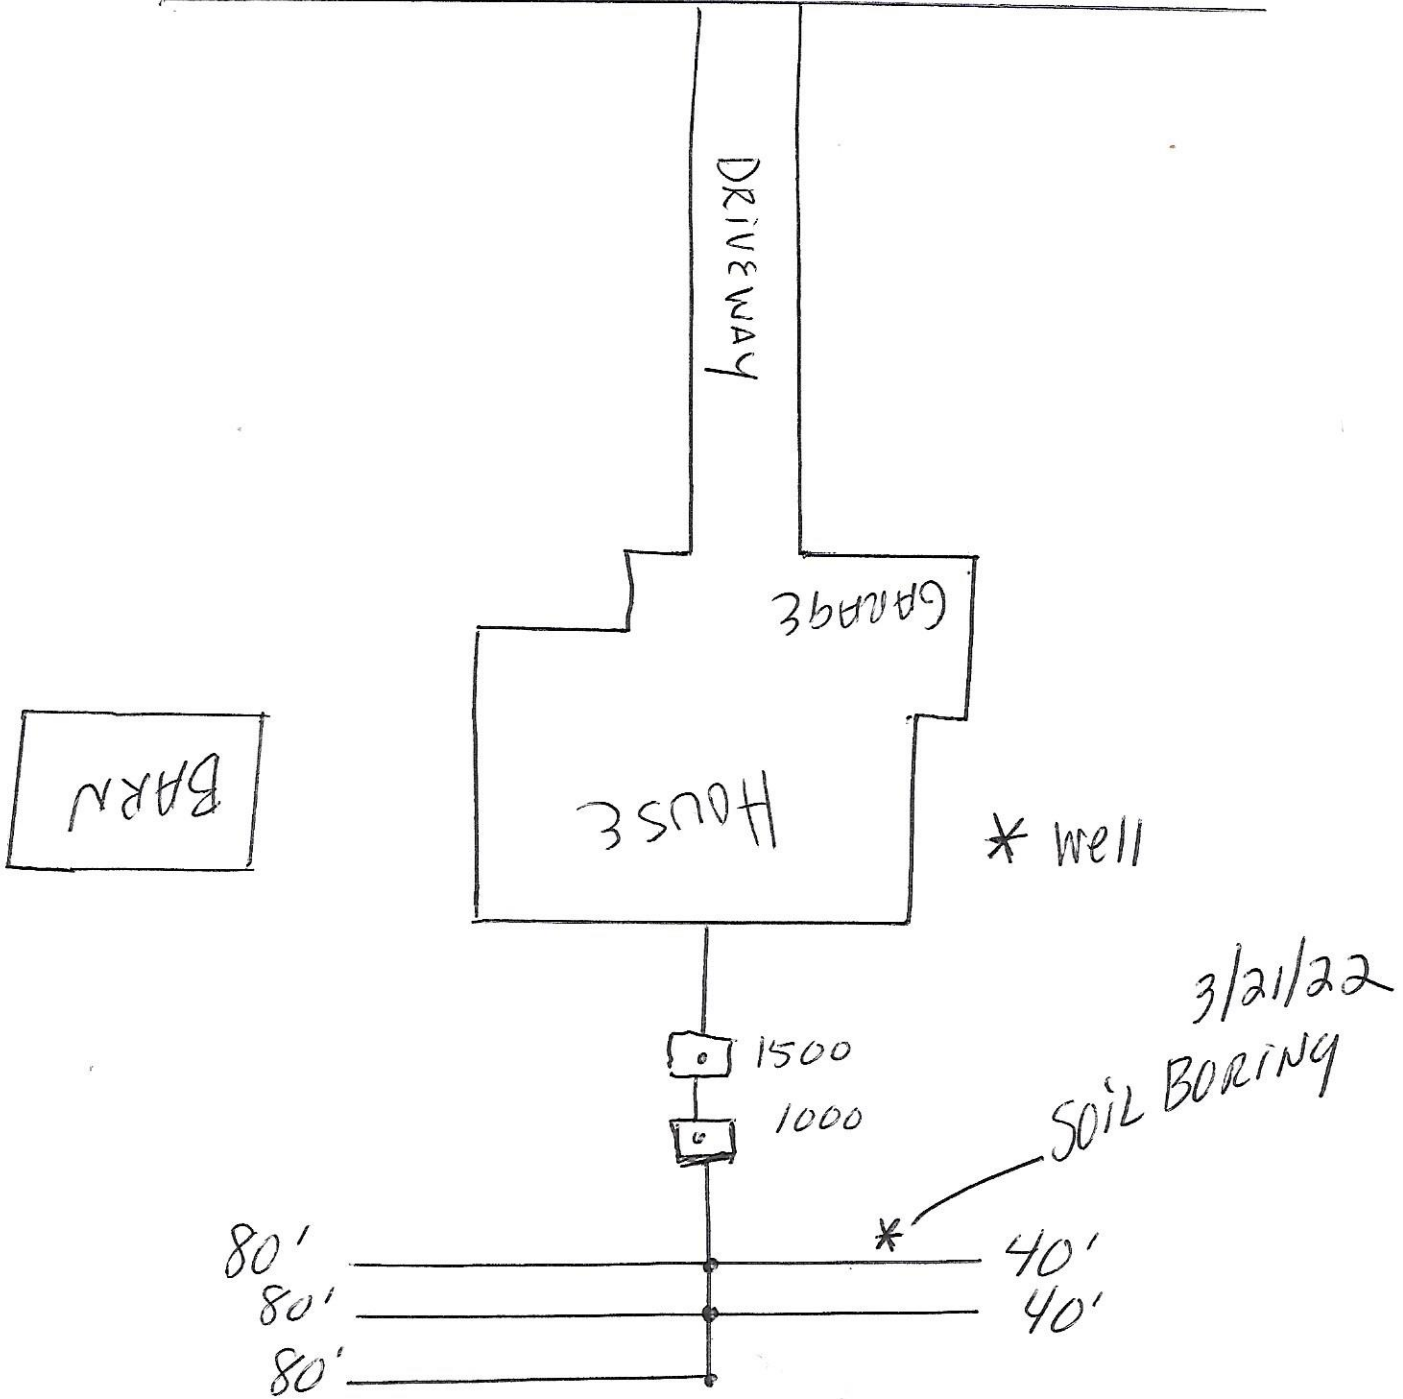

← TREE LINE →