


7889 LAMAR AVES

SHED

\* SOIL BORING

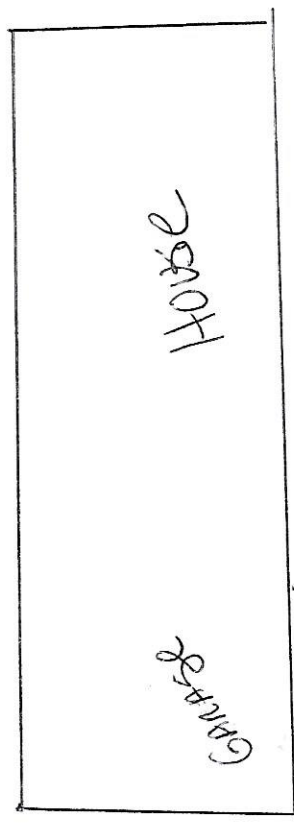

TANK

TANK