


16140 6th St N. Lakeland, MN 55043

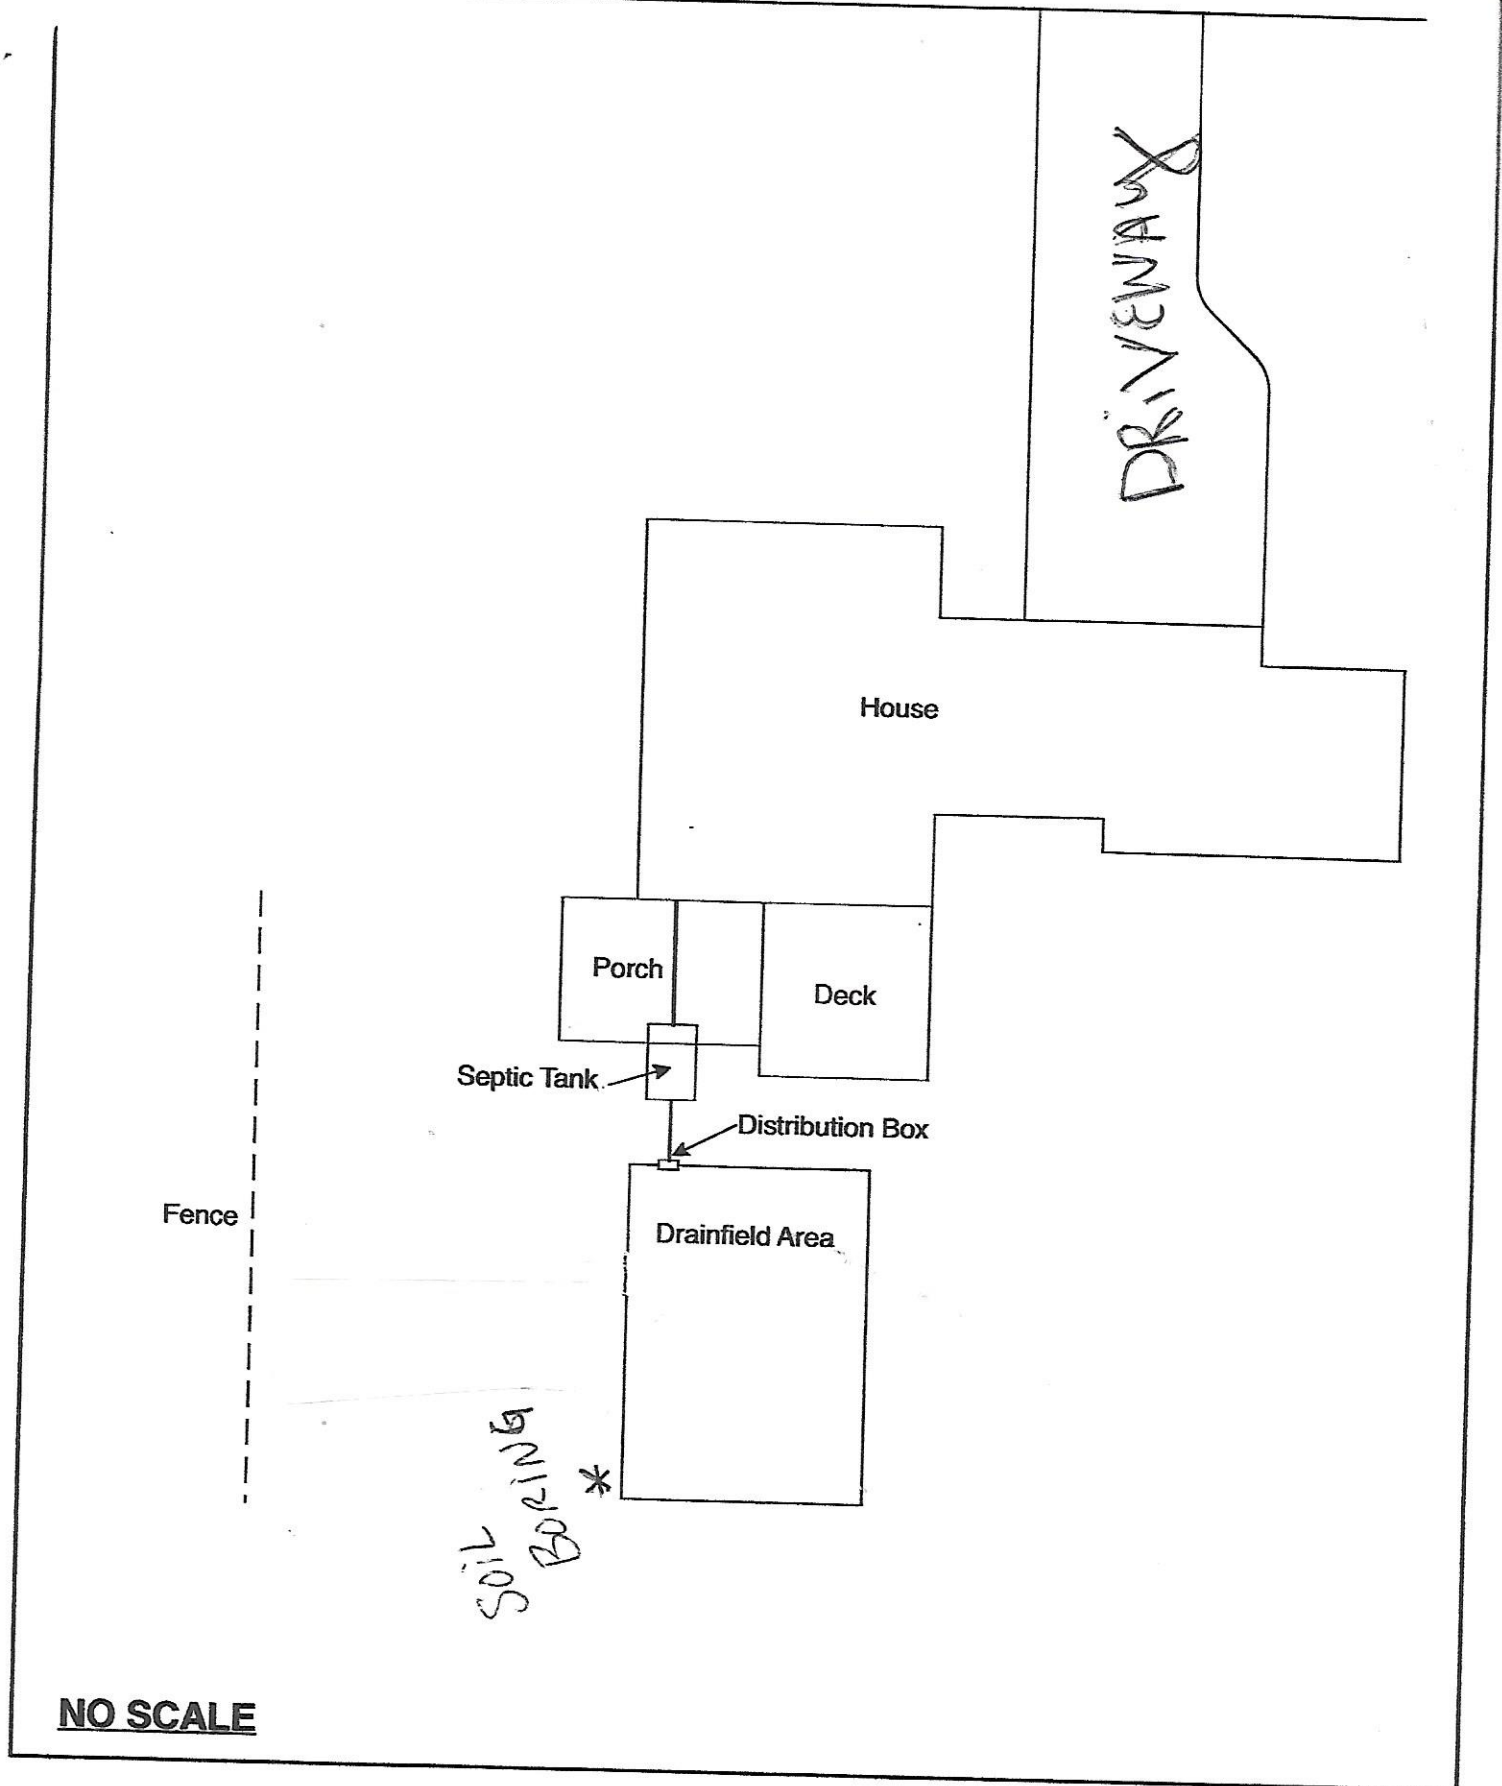

NO SCALE