


Permit # 4584

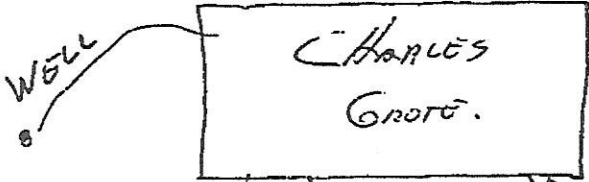

1250 Gal Tank

1000 Gal Lift Station

INSULATED UNDER DRIVE

DRIVEWAY

130' x 1/2" Pump Discharge Line

70' x 3'

90' x 3'

90' x 3'

Drop Boxes

SOIL BORING 4/26/22

Prop. Line

SS

