

Compliance Boring Log

Date: 5/13/2022
 Property Address: 9361 230TH St N, Forest Lake MN 55025
 Property Owner name: Tom Haseltine

Boring 1		Location:		
Soil Horizons Depth	Color	Texture	Structure	Consistence
0-16"	10yr 5/4	Clay Loam	Friable	Weak
Redox 12"				


Boring 2		Location:		
Soil Horizons Depth	Color	Texture	Structure	Consistence
			Friable	Weak
			Friable	Weak

THIS IS NOT A SURVEY

DATE: 5/13/22

9361 230TH ST N, FOREST LAKE

B1

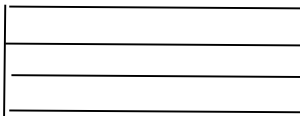


1000 main tank



1000 main tank

75'

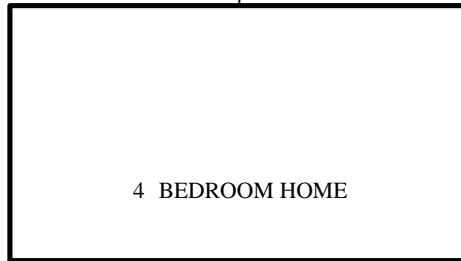

4 BEDROOM HOME

N



