


Hooked up to City WATER

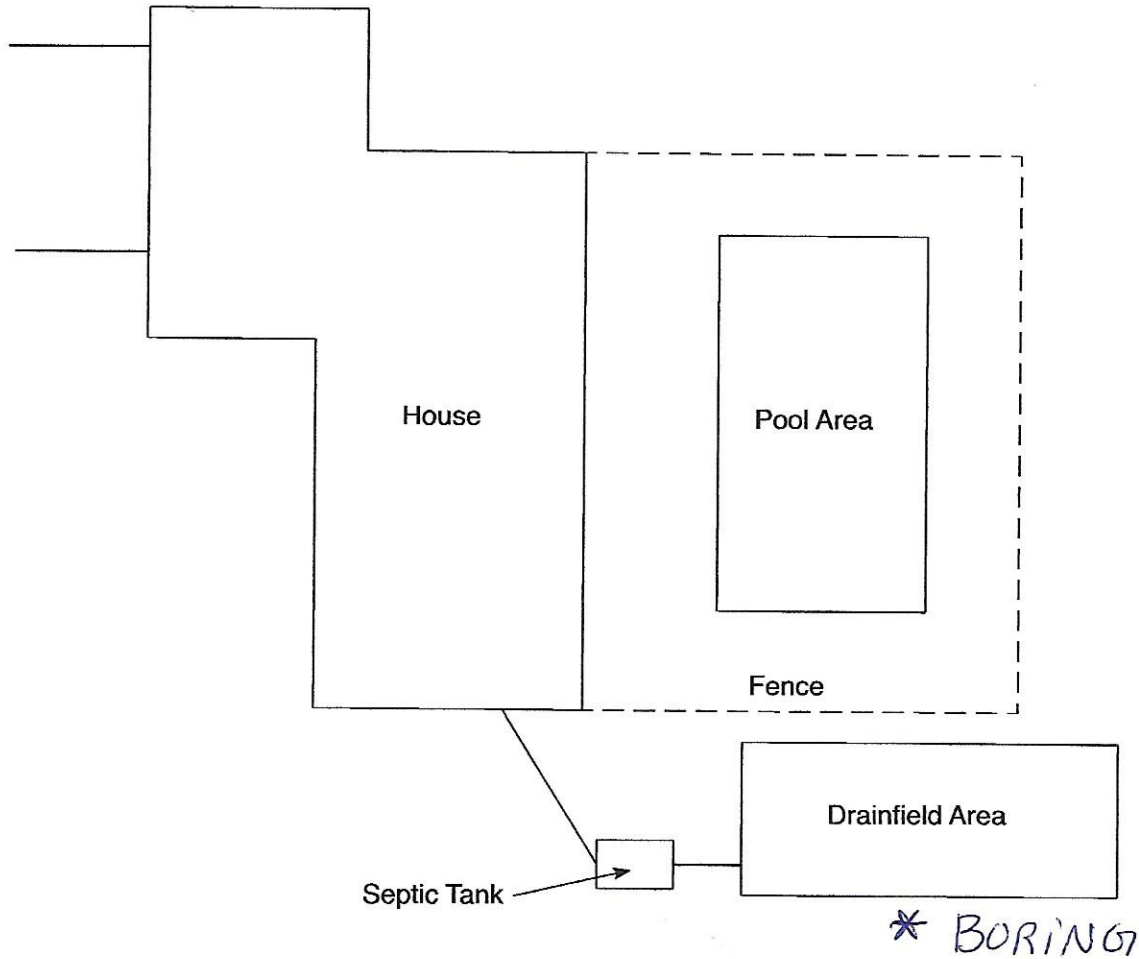

NO SCALE

111 Quinlan Ave S, Lakeland Shores, MN 55043