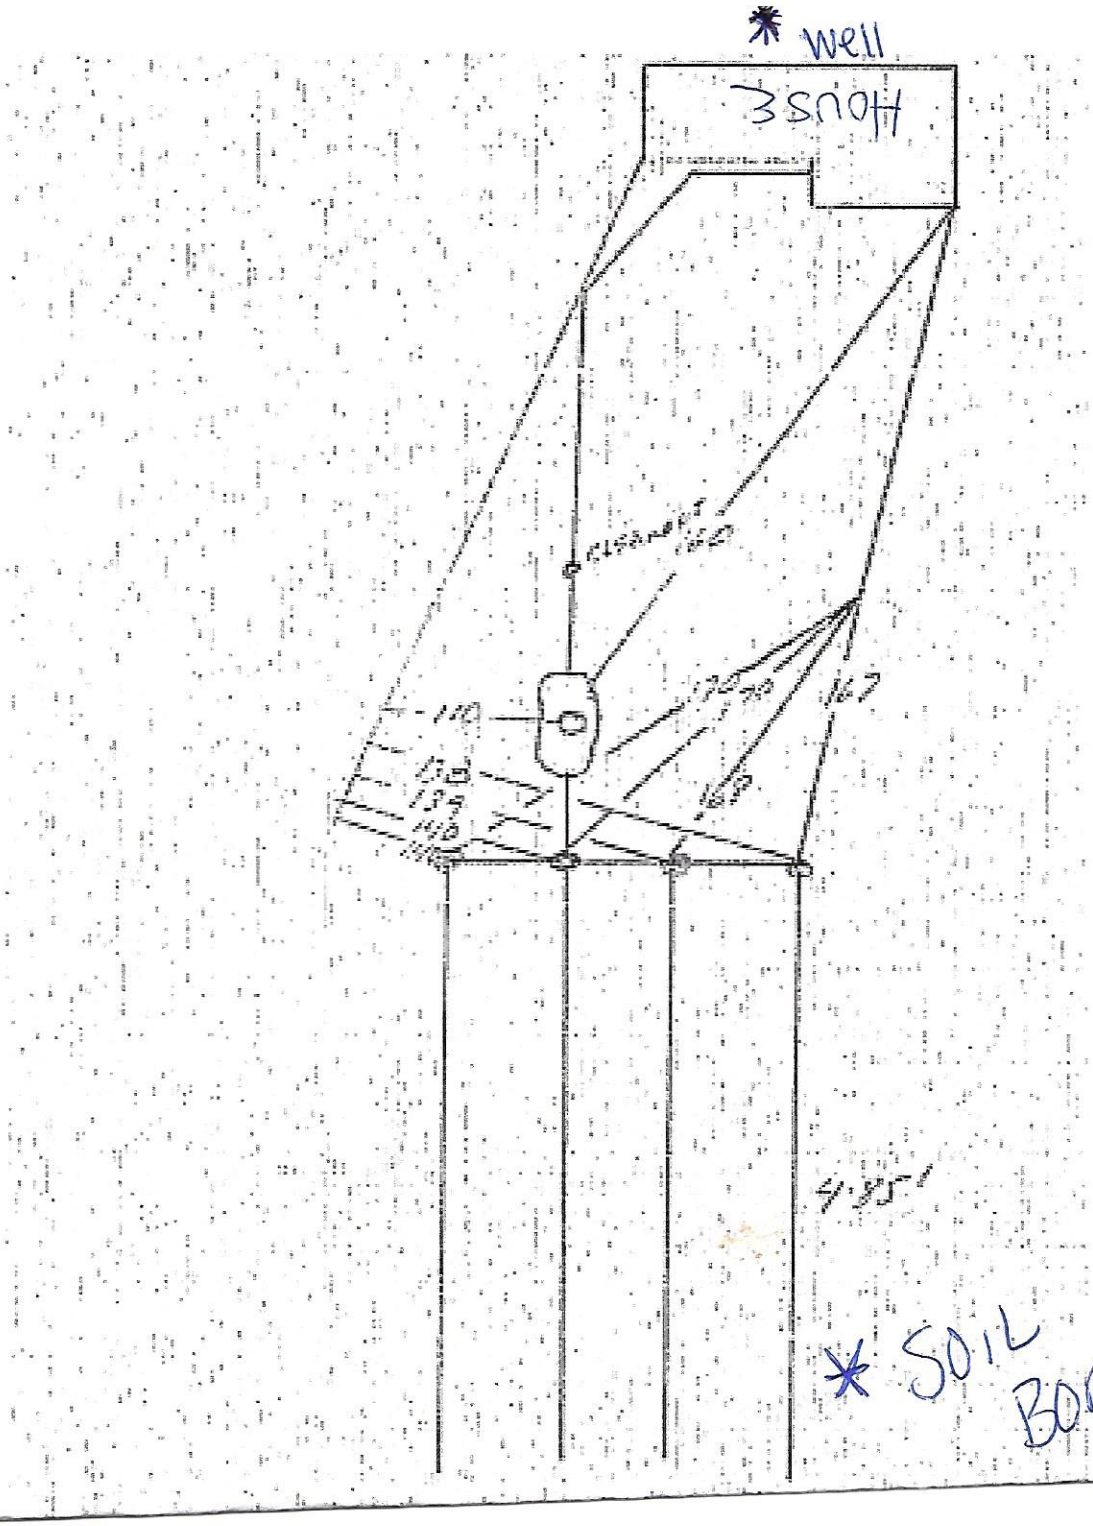
* well
house
* SOIL BORING