


Property Line

\* Well

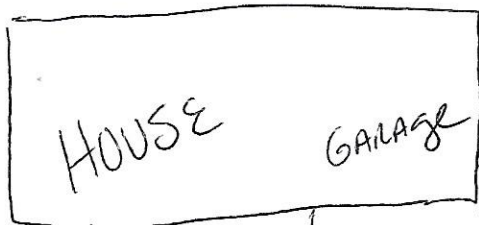

SEPTIC



\* SOIL BORING



DRIVEWAY

