


← Quality Ave N →

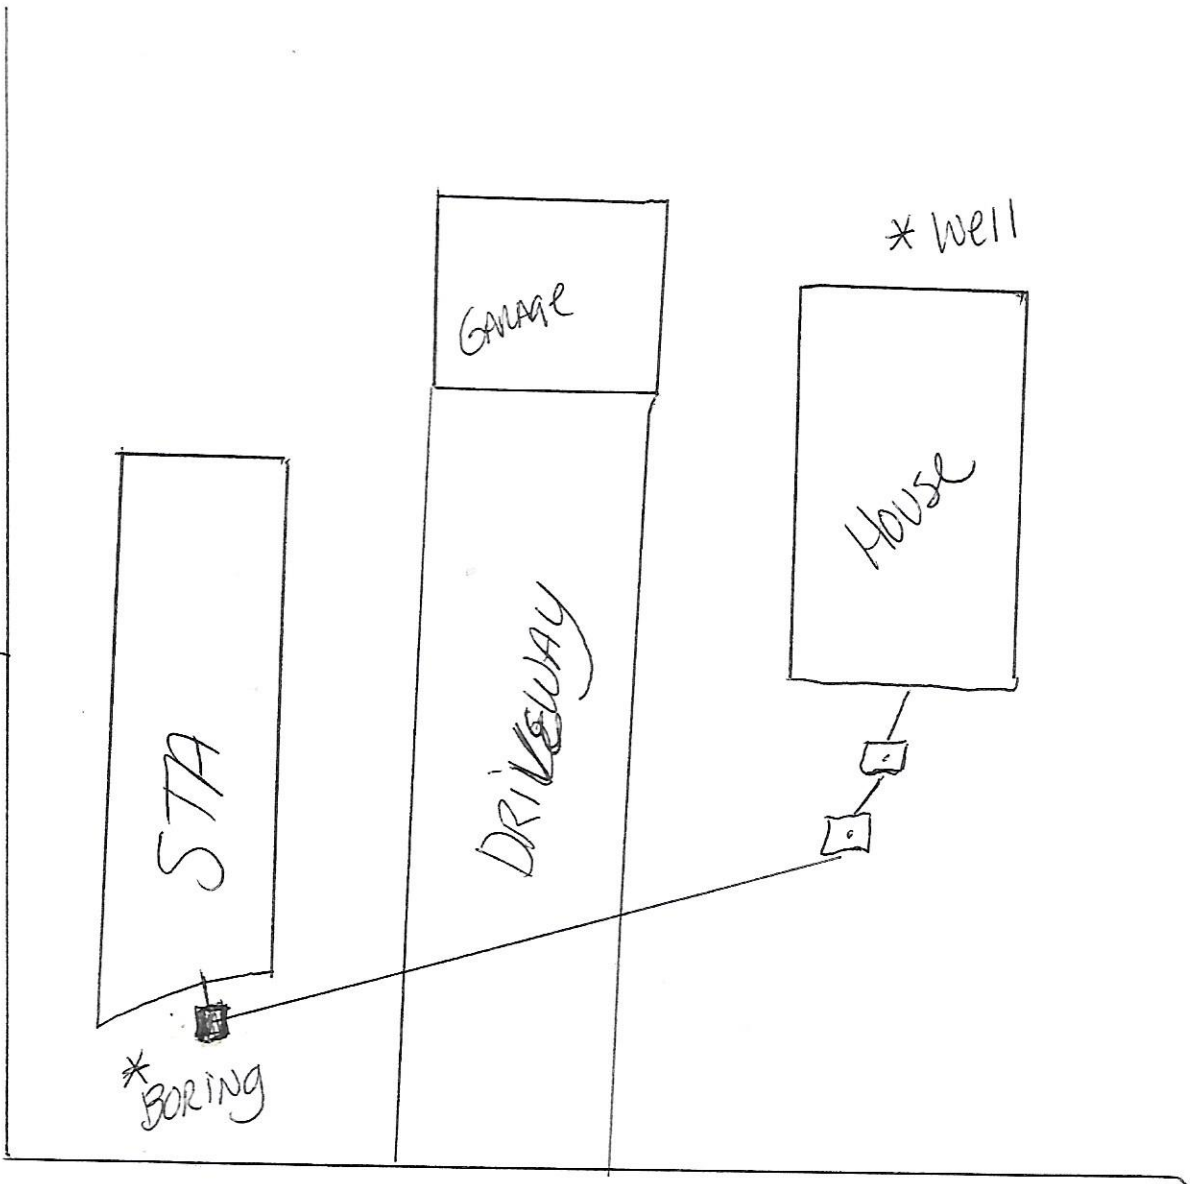

←

Quality COURT S. →