

### Compliance Boring Log


Date: 7/13/2022  
Property Address: 7606 125TH ST N, Hugo  
Property Owner name: MATT BUSSON

<b>Boring 1</b>		Location:		
<b>Soil Horizons Depth</b>	<b>Color</b>	<b>Texture</b>	<b>Structure</b>	<b>Consistence</b>
		Fine Sand	Friable	Weak
		Fine Sand	Friable	Weak

<b>Boring 2</b>		Location:		
<b>Soil Horizons Depth</b>	<b>Color</b>	<b>Texture</b>	<b>Structure</b>	<b>Consistence</b>
			Friable	Weak
			Friable	Weak

THIS IS NOT A SURVEY

47606 125TH ST N WBL

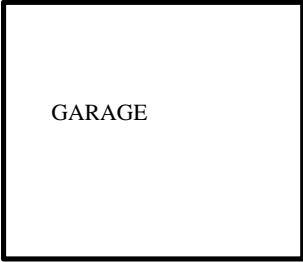


GARAGE



CESSPOOL TANIK

20'

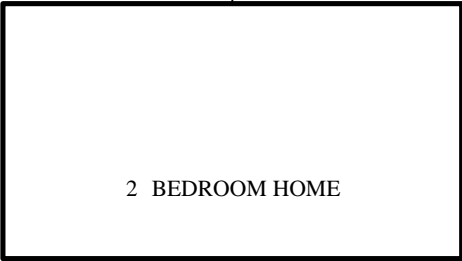

2 BEDROOM HOME

N



