



SOIL BORING 104


SCALE - 1" = 20' APPROX

AMPLE DIST. TO

ALL EXIST. WALLS AND

FEET LINES NO. WELLS

ON PUMP LINE

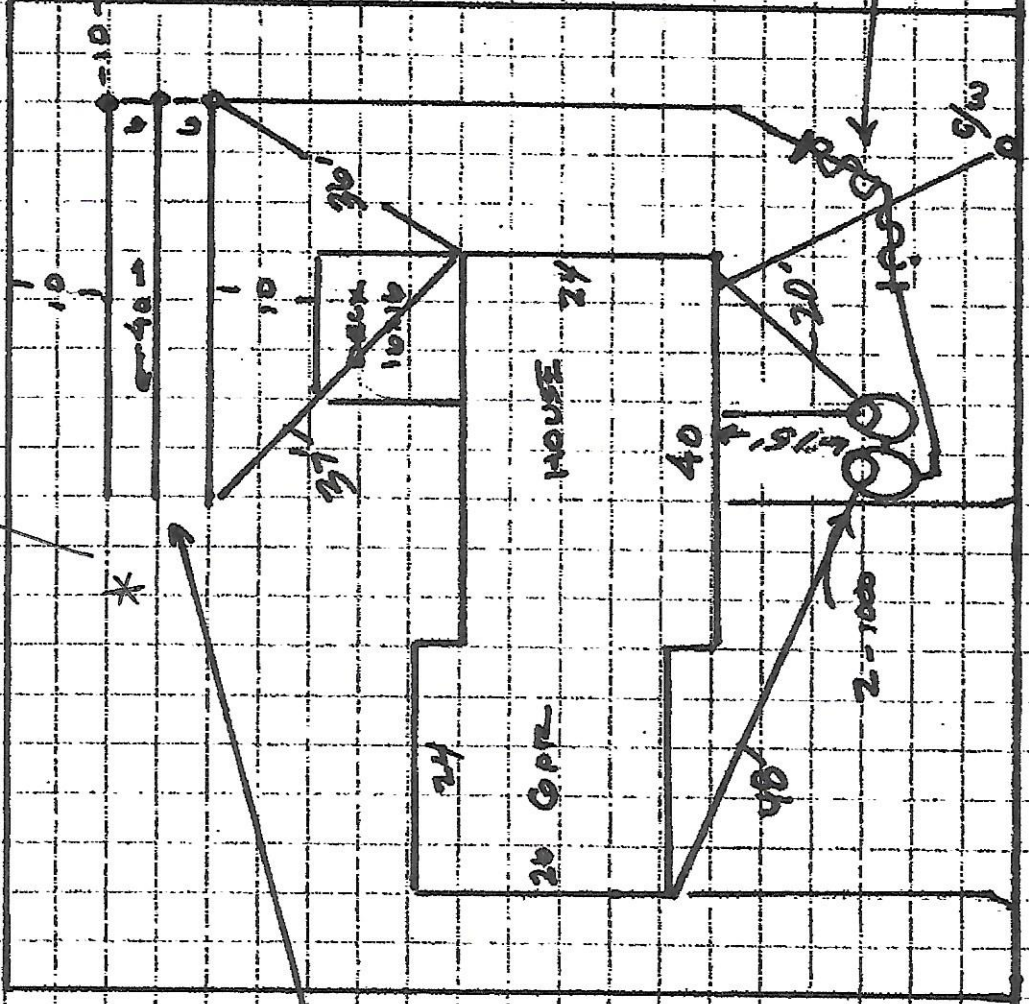

1

21st St