9191 Justen

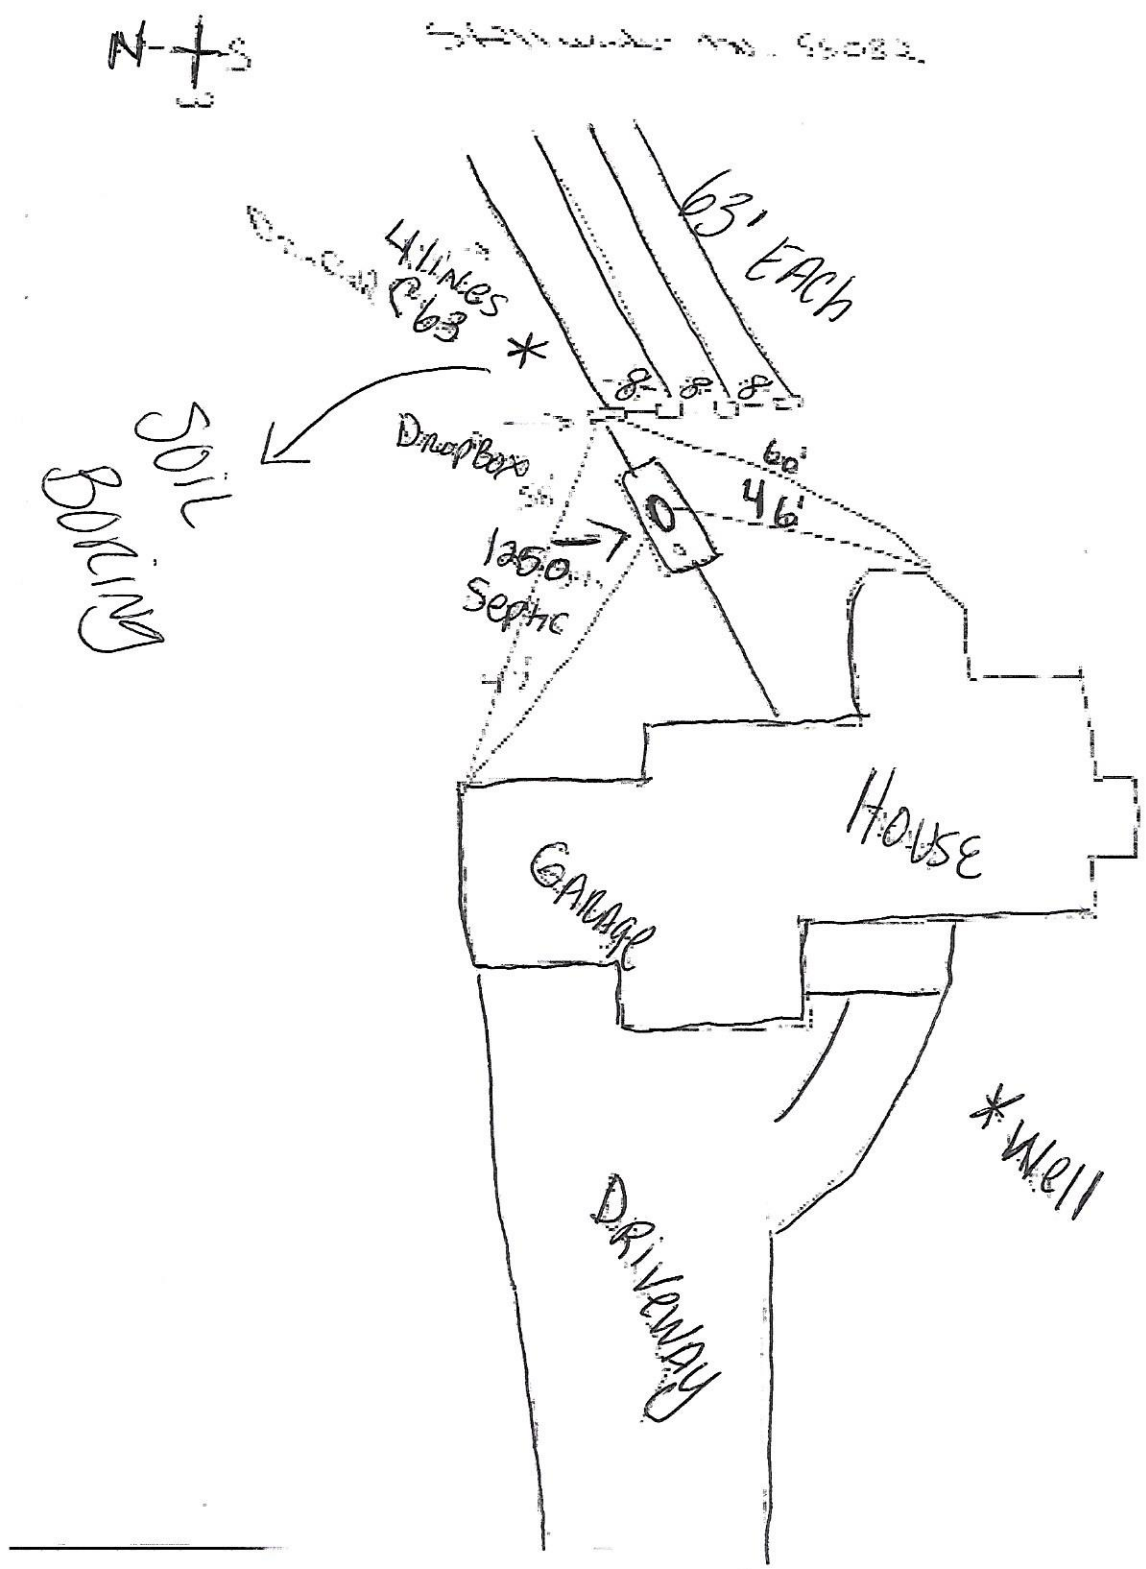
N
S
4 Lines @ 63'
63' EACH
Soil Boring
Drop Box
60'
46'
1250 Septic
HOUSE
GARAGE
WELL
DRIVEWAY