


55043

Oakland Av. S.


309' west line

water line

NO WELL

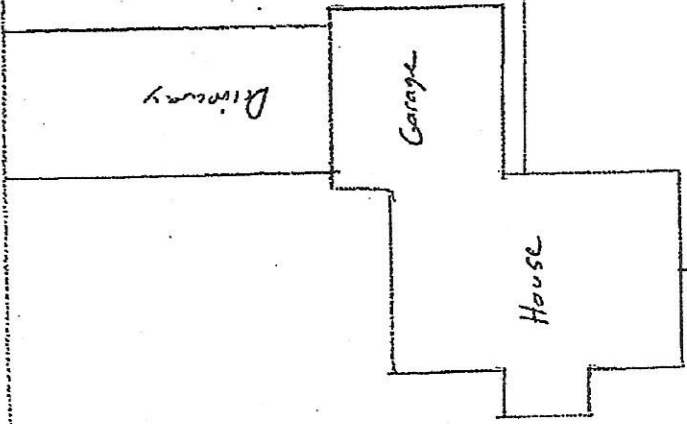

North ↑  
Scale 1/4" = 5'

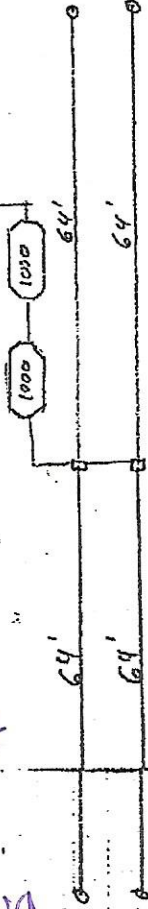

SOIL BORING

East line