


-SOIL BORINGS-

boring are made in order to determine the and structure of soils at various depths as as the location of the water table, impervious or bedrock.

Borings are most easily made with a hand auger, other expedients may be utilized - back post hole auger, etc.

Soils encountered at various depths should be listed appearance, texture and composition.

At which water, bedrock or heavy clay layer encountered should be recorded.

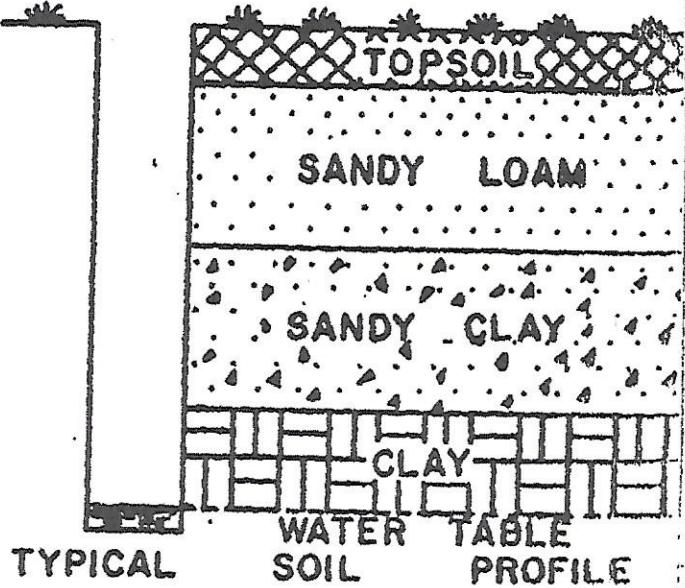

LOG OF SOIL BORING

BORING NO. 5

Depth in Feet	Soil Description
0"	BLACK loam
1	BROWN clay loam
2	
3	REDDISH BROWN medium SANDY clay + Rocks
4	
5	REDDISH BROWN fine - medium SANDY loam + GRAVEL + Rocks

OBSSTRUCTION

6	
7	
8	