


-SOIL BORINGS-

Borings are made in order to determine the kind and structure of soils at various depths as well as the location of the water table, impervious layer or bedrock.

Borings are most easily made with a hand auger, but other expedients may be utilized - back hole auger, etc.

Soils encountered at various depths should be listed with their appearance, texture and composition.

Depth at which water, bedrock or heavy clay layer is encountered should be recorded.

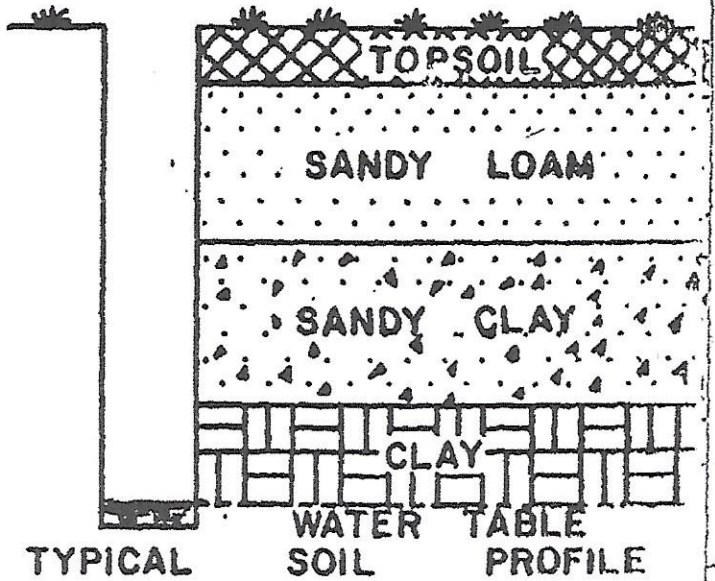

LOG OF SOIL BORING

BORING NO. 3

Depth in Feet	Soil Description
<u>1</u>	<u>Black Loam</u>
<u>2</u>	<u>18" -</u>
<u>3</u>	<u>BROWN clay loam</u>
<u>4</u>	<u>3" - REDDISH BROWN fine-medium SANDY clay</u>
<u>5</u>	<u>4" - REDDISH BROWN medium SANDY loam</u>
<u>6</u>	<u>+ Rocks</u>
<u>7</u>	<u>6" - OBSTRUCTION</u>
<u>8</u>	<u>-</u>