


DRIVEWAY

PROPERTY 2003 AS BUILT

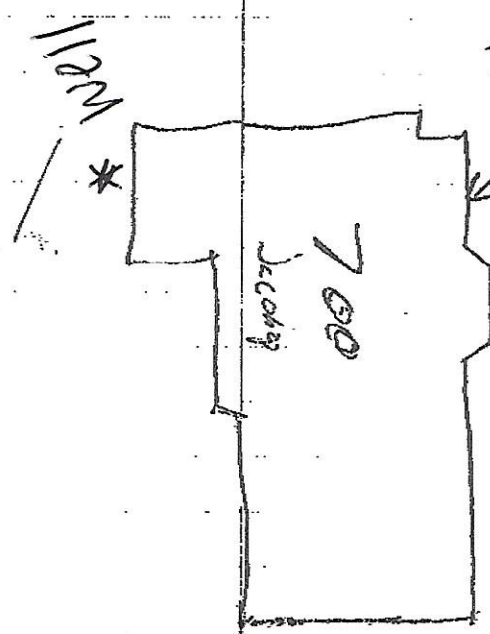

35'

100' 0" DIA

100' 0" DIA

35'



100'

80'

100'

80'

80'

80'

* SOIL BORING

22/10/01

10/11