

Instructions: Inspector must submit completed form to Local Governmental Unit (LGU) and system owner within 15 days of final determination of compliance or noncompliance. Instructions for filling out this form are located on the Minnesota Pollution Control Agency (MPCA) website at <https://www.pca.state.mn.us/sites/default/files/wq-wwists4-31a.pdf>.

Property information

Local tracking number: _____

Parcel ID# or Sec/Twp/Range: 27.027.20.33.0015 Reason for Inspection: property sale
 Local regulatory authority info: Washington County
 Property address: 10909 Paris Ave S Denmark Twp, MN 55033
 Owner/representative: George Miller Owner's phone: 651-208-3739
 Brief system description: 2 septic tanks and a gravity rock trench drainfield.

System status

System status on date (mm/dd/yyyy): 9/21/2022

Compliant – Certificate of compliance*

Noncompliant – Notice of noncompliance

(Valid for 3 years from report date unless evidence of an imminent threat to public health or safety requiring removal and abatement under section 145A.04, subdivision 8 is discovered or a shorter time frame exists in Local Ordinance.)

Systems failing to protect ground water must be upgraded, replaced, or use discontinued within the time required by local ordinance.

An imminent threat to public health and safety (ITPHS) must be upgraded, replaced, or its use discontinued within ten months of receipt of this notice or within a shorter period if required by local ordinance or under section 145A.04 subdivision 8.

***Note: Compliance indicates conformance with Minn. R. 7080.1500 as of system status date above and does not guarantee future performance.**

Reason(s) for noncompliance (check all applicable)

- Impact on public health (Compliance component #1) – *Imminent threat to public health and safety*
- Tank integrity (Compliance component #2) – *Failing to protect groundwater*
- Other Compliance Conditions (Compliance component #3) – *Imminent threat to public health and safety*
- Other Compliance Conditions (Compliance component #3) – *Failing to protect groundwater*
- System not abandoned according to Minn. R. 7080.2500 (Compliance component #3) – *Failing to protect groundwater*
- Soil separation (Compliance component #5) – *Failing to protect groundwater*
- Operating permit/monitoring plan requirements (Compliance component #4) – *Noncompliant - local ordinance applies*

Comments or recommendations

Reviewed design, permit, soil, inspection and pumping records on file at Washington County.

Certification

I hereby certify that all the necessary information has been gathered to determine the compliance status of this system. No determination of future system performance has been nor can be made due to unknown conditions during system construction, possible abuse of the system, inadequate maintenance, or future water usage.

By typing my name below. I certify the above statements to be true and correct, to the best of my knowledge, and that this information can be used for the purpose of processing this form.

Business name: All State Septic Services LLC Certification number: 323

Inspector signature: Tom Trooien License number: 1568

(This document has been electronically signed)

Phone: 612-594-4496

Necessary or locally required supporting documentation (must be attached)

- Soil observation logs
- System/As-Built
- Locally required forms
- Tank Integrity Assessment
- Operating Permit
- Other information (list): Statement from owner refusing to remove solids and liquids through maintenance hole

1. Impact on public health – Compliance component #1 of 5

Compliance criteria:

System discharges sewage to the ground surface	<input type="checkbox"/> Yes <input checked="" type="checkbox"/> No
System discharges sewage to drain tile or surface waters.	<input type="checkbox"/> Yes <input checked="" type="checkbox"/> No
System causes sewage backup into dwelling or establishment.	<input type="checkbox"/> Yes <input checked="" type="checkbox"/> No

Any "yes" answer above indicates the system is an imminent threat to public health and safety

Describe verification methods and results:

None of the above observed.

Attached supporting documentation:

- Other: _____
- Not applicable

2. Tank integrity – Compliance component #2 of 5

Compliance criteria:

System consists of a seepage pit, cesspool, drywell, leaching pit, or other pit?	<input type="checkbox"/> Yes <input checked="" type="checkbox"/> No
Sewage tank(s) leak below their designed operating depth?	<input type="checkbox"/> Yes <input checked="" type="checkbox"/> No
If yes, which sewage tank(s) leaks:	

Any "yes" answer above indicates the system is failing to protect groundwater.

Describe verification methods and results:

The maintenance hole covers are buried 1.5' below grade and the owner refused to expose the covers. See attached signed statement by the owner refusing to allow the removal of solids and liquids through the maintenance hole.

The tanks were at normal operating level, then were pumped through the pumping pipe for the inspection. Lowered a camera into the empty tanks - bottoms, walls, covers, baffles, risers and maintenance hole covers ok.

Attached supporting documentation:

- Empty tank(s) viewed by inspector
- Name of maintenance business: Pinky's Sewer Service
- License number of maintenance business: 9755
- Date of maintenance: 9/21/2022
- Existing tank integrity assessment (Attach)
- Date of maintenance (mm/dd/yyyy): _____ (must be within three years)
- (See form instructions to ensure assessment complies with Minn. R. 7082.0700 subp. 4 B (1))*
- Tank is Noncompliant (pumping not necessary – explain below)
- Other: _____

3. Other compliance conditions – Compliance component #3 of 5

3a. Maintenance hole covers appear to be structurally unsound (damaged, cracked, etc.), or unsecured?

Yes No Unknown

3b. Other issues (electrical hazards, etc.) to immediately and adversely impact public health or safety? Yes No Unknown

**Yes to 3a or 3b - System is an imminent threat to public health and safety.*

3c. System is non-protective of ground water for other conditions as determined by inspector? Yes No

3d. System not abandoned in accordance with Minn. R. 7080.2500? Yes No

**Yes to 3c or 3d - System is failing to protect groundwater*

Describe verification methods and results:

Attached supporting documentation: Not applicable

4. Operating permit and nitrogen BMP* – Compliance component #4 of 5 Not applicable

Is the system operated under an Operating Permit? Yes No **If "yes", A below is required**

Is the system required to employ a Nitrogen BMP specified in the system design? Yes No **If "yes", B below is required**

BMP = Best Management Practice(s) specified in the system design

If the answer to both questions is "no", this section does not need to be completed.

Compliance criteria:

a. Have the operating permit requirements been met? Yes No

b. Is the required nitrogen BMP in place and properly functioning? Yes No

Any "no" answer indicates noncompliance.

Describe verification methods and results:

Attached supporting documentation: Operating permit (Attach)

5. Soil separation – Compliance component #5 of 5

Date of installation 12/10/1993 Unknown
(mm/dd/yyyy)

Shoreland/Wellhead protection/Food beverage lodging? Yes No

Compliance criteria (select one):

5a. For systems built prior to April 1, 1996, and not located in Shoreland or Wellhead Protection Area or not serving a food, beverage or lodging establishment: Yes No
 Drainfield has at least a two-foot vertical separation distance from periodically saturated soil or bedrock.

5b. Non-performance systems built April 1, 1996, or later or for non-performance systems located in Shoreland or Wellhead Protection Areas or serving a food, beverage, or lodging establishment: Yes No
 Drainfield has a three-foot vertical separation distance from periodically saturated soil or bedrock.*

5c. "Experimental", "Other", or "Performance" systems built under pre-2008 Rules; Type IV or V systems built under 2008 Rules 7080, 2350 or 7080.2400 (Intermediate Inspector License required ≤ 2,500 gallons per day; Advanced Inspector License required > 2,500 gallons per day) Yes No
 Drainfield meets the designed vertical separation distance from periodically saturated soil or bedrock.

Attached supporting documentation:

- Soil observation logs completed for the report
- Two previous verifications of required vertical separation
- Not applicable (No soil treatment area)
- _____

Indicate depths or elevations

A. Bottom of distribution media	2.7
B. Periodically saturated soil/bedrock	4.9
C. System separation	2.2
D. Required compliance separation*	2.0


*May be reduced up to 15 percent if allowed by Local Ordinance.

Any "no" answer above indicates the system is failing to protect groundwater.

Describe verification methods and results:


Reviewed design, permit, soil, inspection and pumping records on file at Washington County.

Upgrade requirements: (Minn. Stat. § 115.55) An imminent threat to public health and safety (ITPHS) must be upgraded, replaced, or its use discontinued within ten months of receipt of this notice or within a shorter period if required by local ordinance. If the system is failing to protect ground water, the system must be upgraded, replaced, or its use discontinued within the time required by local ordinance. If an existing system is not failing as defined in law, and has at least two feet of design soil separation, then the system need not be upgraded, repaired, replaced, or its use discontinued, notwithstanding any local ordinance that is more strict. This provision does not apply to systems in shoreland areas, Wellhead Protection Areas, or those used in connection with food, beverage, and lodging establishments as defined in law.

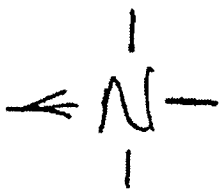

x Proposed well (Not in when AS Built was drawn)

⊗ B-2 9/21/22

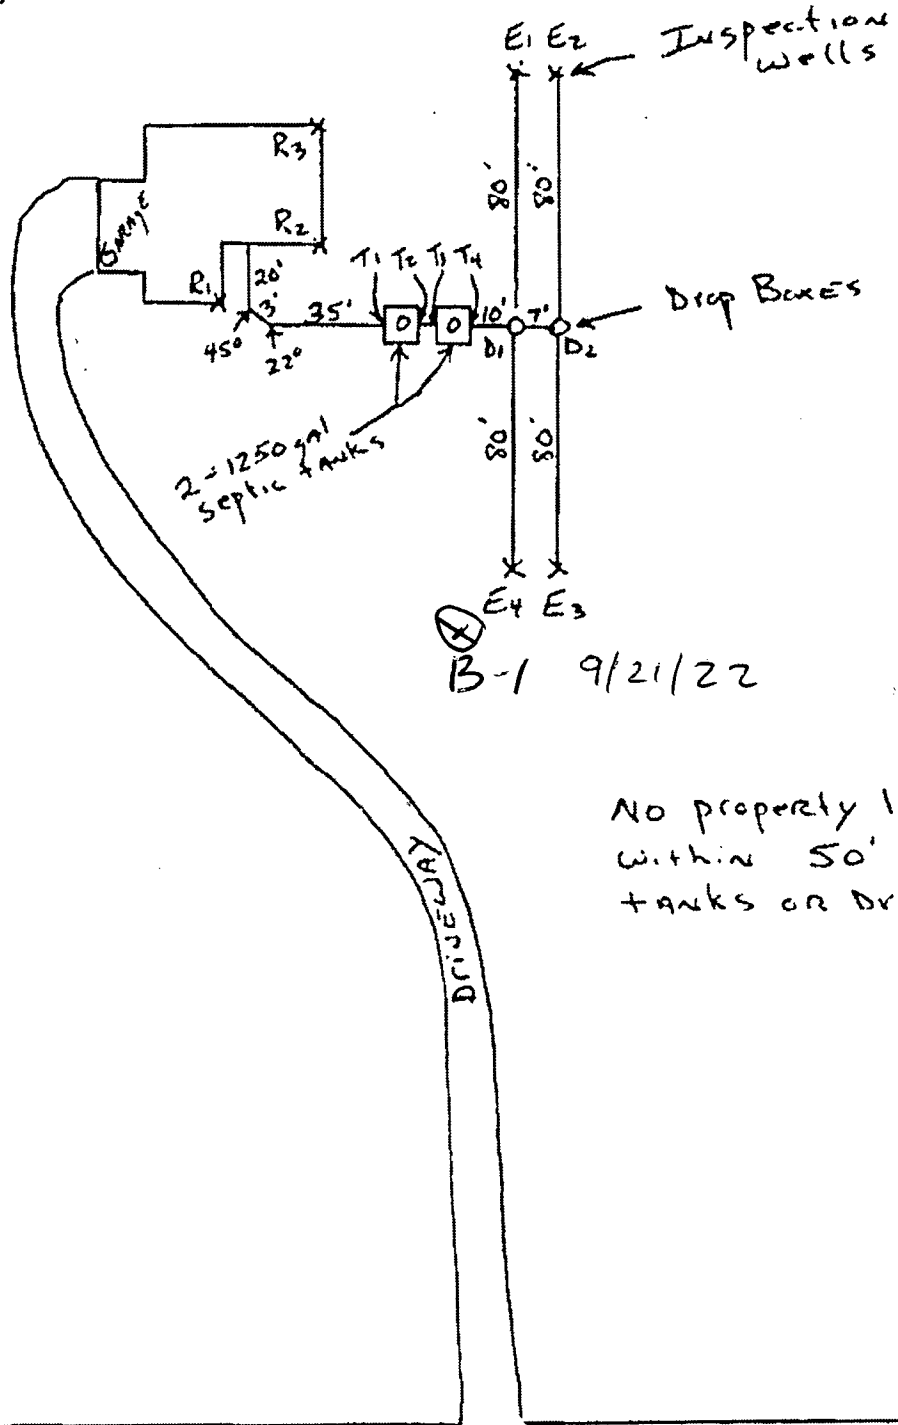

- R₁ to T₁ - 42'
- T₂ - 52
- T₃ - 53
- T₄ - 63
- R₂ to T₁ - 24
- T₂ - 29
- T₃ - 29.5
- T₄ - 37
- D₁ - 45
- D₂ - 51.5
- E₁ - 73
- E₂ - 78
- E₃ - 112
- E₄ - 118
- R₃ to D₁ - 69
- D₂ - 73
- E₁ - 51
- E₂ - 57
- E₃ - 144
- E₄ - 142

⊗ B-1 9/21/22

No property line within 50' of tanks or drain

PARIS AVE



Soil Observation Log

Project ID: v 04.01.2021

Client: George Miller		Location / Address: 10909 Paris Ave S Denmark Twp, MN 55033	
Soil parent material(s): (Check all that apply)		<input type="checkbox"/> Outwash <input type="checkbox"/> Lacustrine <input type="checkbox"/> Loess <input type="checkbox"/> Till <input type="checkbox"/> Alluvium <input type="checkbox"/> Bedrock <input type="checkbox"/> Organic Matter	
Landscape Position: (select one)		Slope shape	
Vegetation: lawn		Slope %:	
Weather Conditions/Time of Day: clear am		Date: 09/21/22	
Observation #/Location: B-1		Observation Type: Auger	
Depth (in)	Texture	Rock Frag. %	Matrix Color(s)
0-16	loam	<35%	10YR 2/2
16-42	loam	<35%	10YR 4/3
42-59	loam	<35%	10YR 5/4
59-66	sandy loam	<35%	7.5YR 4/4
			10YR 6/8 Concentrations S1
			10YR 5/2 Depletions S1
Comments: Faint redox at 59'			
I hereby certify that I have completed this work in accordance with all applicable ordinances, rules and laws.			
Tom Trooien (Designer/Inspector)		Tom Trooien (Signature)	
		1568 (License #)	
		9/21/22 (Date)	

Elevation-relative to benchmark:

Limiting Layer Elevation:

Structure-----|
Shape Grade Consistence



Sewage tank maintenance reporting form

Reporting information

Date of maintenance (mm/dd/yyyy): 9/21/22 Reason for maintenance: Routine
 Property address: 10909 Paris Ave So Parcel ID: _____
 City: Hobbsville State: MN Zip code: 55033
 Property owner's name: George Miller
 Property-owner's address if different: _____
 City: _____ State: _____ Zip code: _____
 Phone number: _____ Email address: _____

1. Did you measure the accumulation of scum and sludge? Yes No (tank(s) pumped without measuring)

Tank (check if present)	Scum	Sludge	Operating depth	Percent full
<input type="checkbox"/> Septic/holding tank #1				
<input type="checkbox"/> Septic/holding tank #2				
<input type="checkbox"/> Pretreatment tank				
<input type="checkbox"/> Pump tank				

2. Access used to remove septage: Maintenance hole Other (Unless a holding tank, go to #4 below)
 3. If the maintenance hole was used, were all covers secured in place? Yes No If no, please explain below:

4. If the owner refuses to allow a Subsurface Sewage Treatment System (SSTS) to be pumped through the maintenance hole, have them complete and sign the following statement.
 I, George Miller (Print owner's name), refuse to allow the removal of the solids and liquids through the maintenance hole. I understand that removal of solids and liquids through other access points is not considered a compliant method of solids removal and does not fulfill the solids removal requirements of Minn. R. 7080.2450 and 7082.0500.
 By typing/signing my name below, I certify the above statements to be true and correct, to the best of my knowledge, and that this information can be used for the purpose of processing this form.
 Owner's signature: _____ Date (mm/dd/yyyy): 9/27/2020

5. Is the tank designed as a leaky tank? (Example: seepage pit, cesspool, drywell, leaching pit)
 Tank #1: Yes No Verification method used: visual
 Tank #2: Yes No Verification method used: visual

6. Is there evidence of the following?

Tank (check if present)	Tank leaks below the designed operating depth	Tank leaks above the designed operating depth	Maintenance hole cover is damaged, cracked, unsecured, or appears to be structurally unsound
<input checked="" type="checkbox"/> Septic/holding Tank #1	<input type="checkbox"/> Yes <input checked="" type="checkbox"/> No	<input type="checkbox"/> Yes <input checked="" type="checkbox"/> No	<input type="checkbox"/> Yes <input checked="" type="checkbox"/> No
<input type="checkbox"/> Septic/holding Tank #2	<input type="checkbox"/> Yes <input checked="" type="checkbox"/> No	<input type="checkbox"/> Yes <input checked="" type="checkbox"/> No	<input type="checkbox"/> Yes <input checked="" type="checkbox"/> No
<input type="checkbox"/> Pretreatment Tank	<input type="checkbox"/> Yes <input checked="" type="checkbox"/> No	<input type="checkbox"/> Yes <input checked="" type="checkbox"/> No	<input type="checkbox"/> Yes <input checked="" type="checkbox"/> No
<input type="checkbox"/> Pump Tank	<input type="checkbox"/> Yes <input checked="" type="checkbox"/> No	<input type="checkbox"/> Yes <input checked="" type="checkbox"/> No	<input type="checkbox"/> Yes <input checked="" type="checkbox"/> No

Describe detail for any "Yes"

7. How many gallons of septage were removed?
 Tank #1: 1500 Tank #2: 1000 Pretreatment Tank _____ Pump Tank checked

8. Where was the septage taken? Wastewater treatment facility Land application Other
 Explanation (Facility name/Site #): Met Council Metro Point

9. Did you identify any operational issues or unsafe conditions while assessing the sewage tanks in this system?
 Yes No If yes, identify tank and explain:
 Evidence of non-domestic waste Baffle(s) condition Effluent screen condition
 Maintenance hole and extensions condition Other conditions (e.g. structural integrity of tank or lid, electrical hazard, etc.)
 Explanation: _____

10. List any troubleshooting and minor repairs completed or declined by owner:
 Troubleshooting and repairs conducted Repairs declined by owner
None

Additional comments or suggestions for owner's consideration

Pumping record

Company information

Pinky's Sewer Service
 PO Box 354 Afton, MN 55001
 651-439-4867 4847
 MN License 1673
 WI License 2118

Employee's signature: Eddie Opus