

Compliance Boring Log

Date: 1/29/2024
Property Address: 11960 July Avenue, Hugo MN 55038
Property Owner name: Leanne Bryant


Boring 1				
Soil Horizons Depth	Color	Texture	Structure	Consistence
0-12"	10YR 4/4	Clay Loam	Blocky	Moderate
Redox 12"				

Boring 2				
Soil Horizons Depth	Color	Texture	Structure	Consistence

Boring 3				
Soil Horizons Depth	Color	Texture	Structure	Consistence

THIS IS NOT A SURVEY
11960 JULY AVE HUGO MN

B1

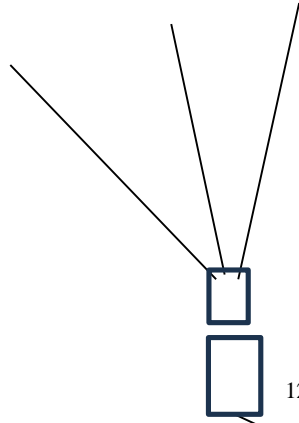

1250 TANK

3 BEDROOM HOME

N



