


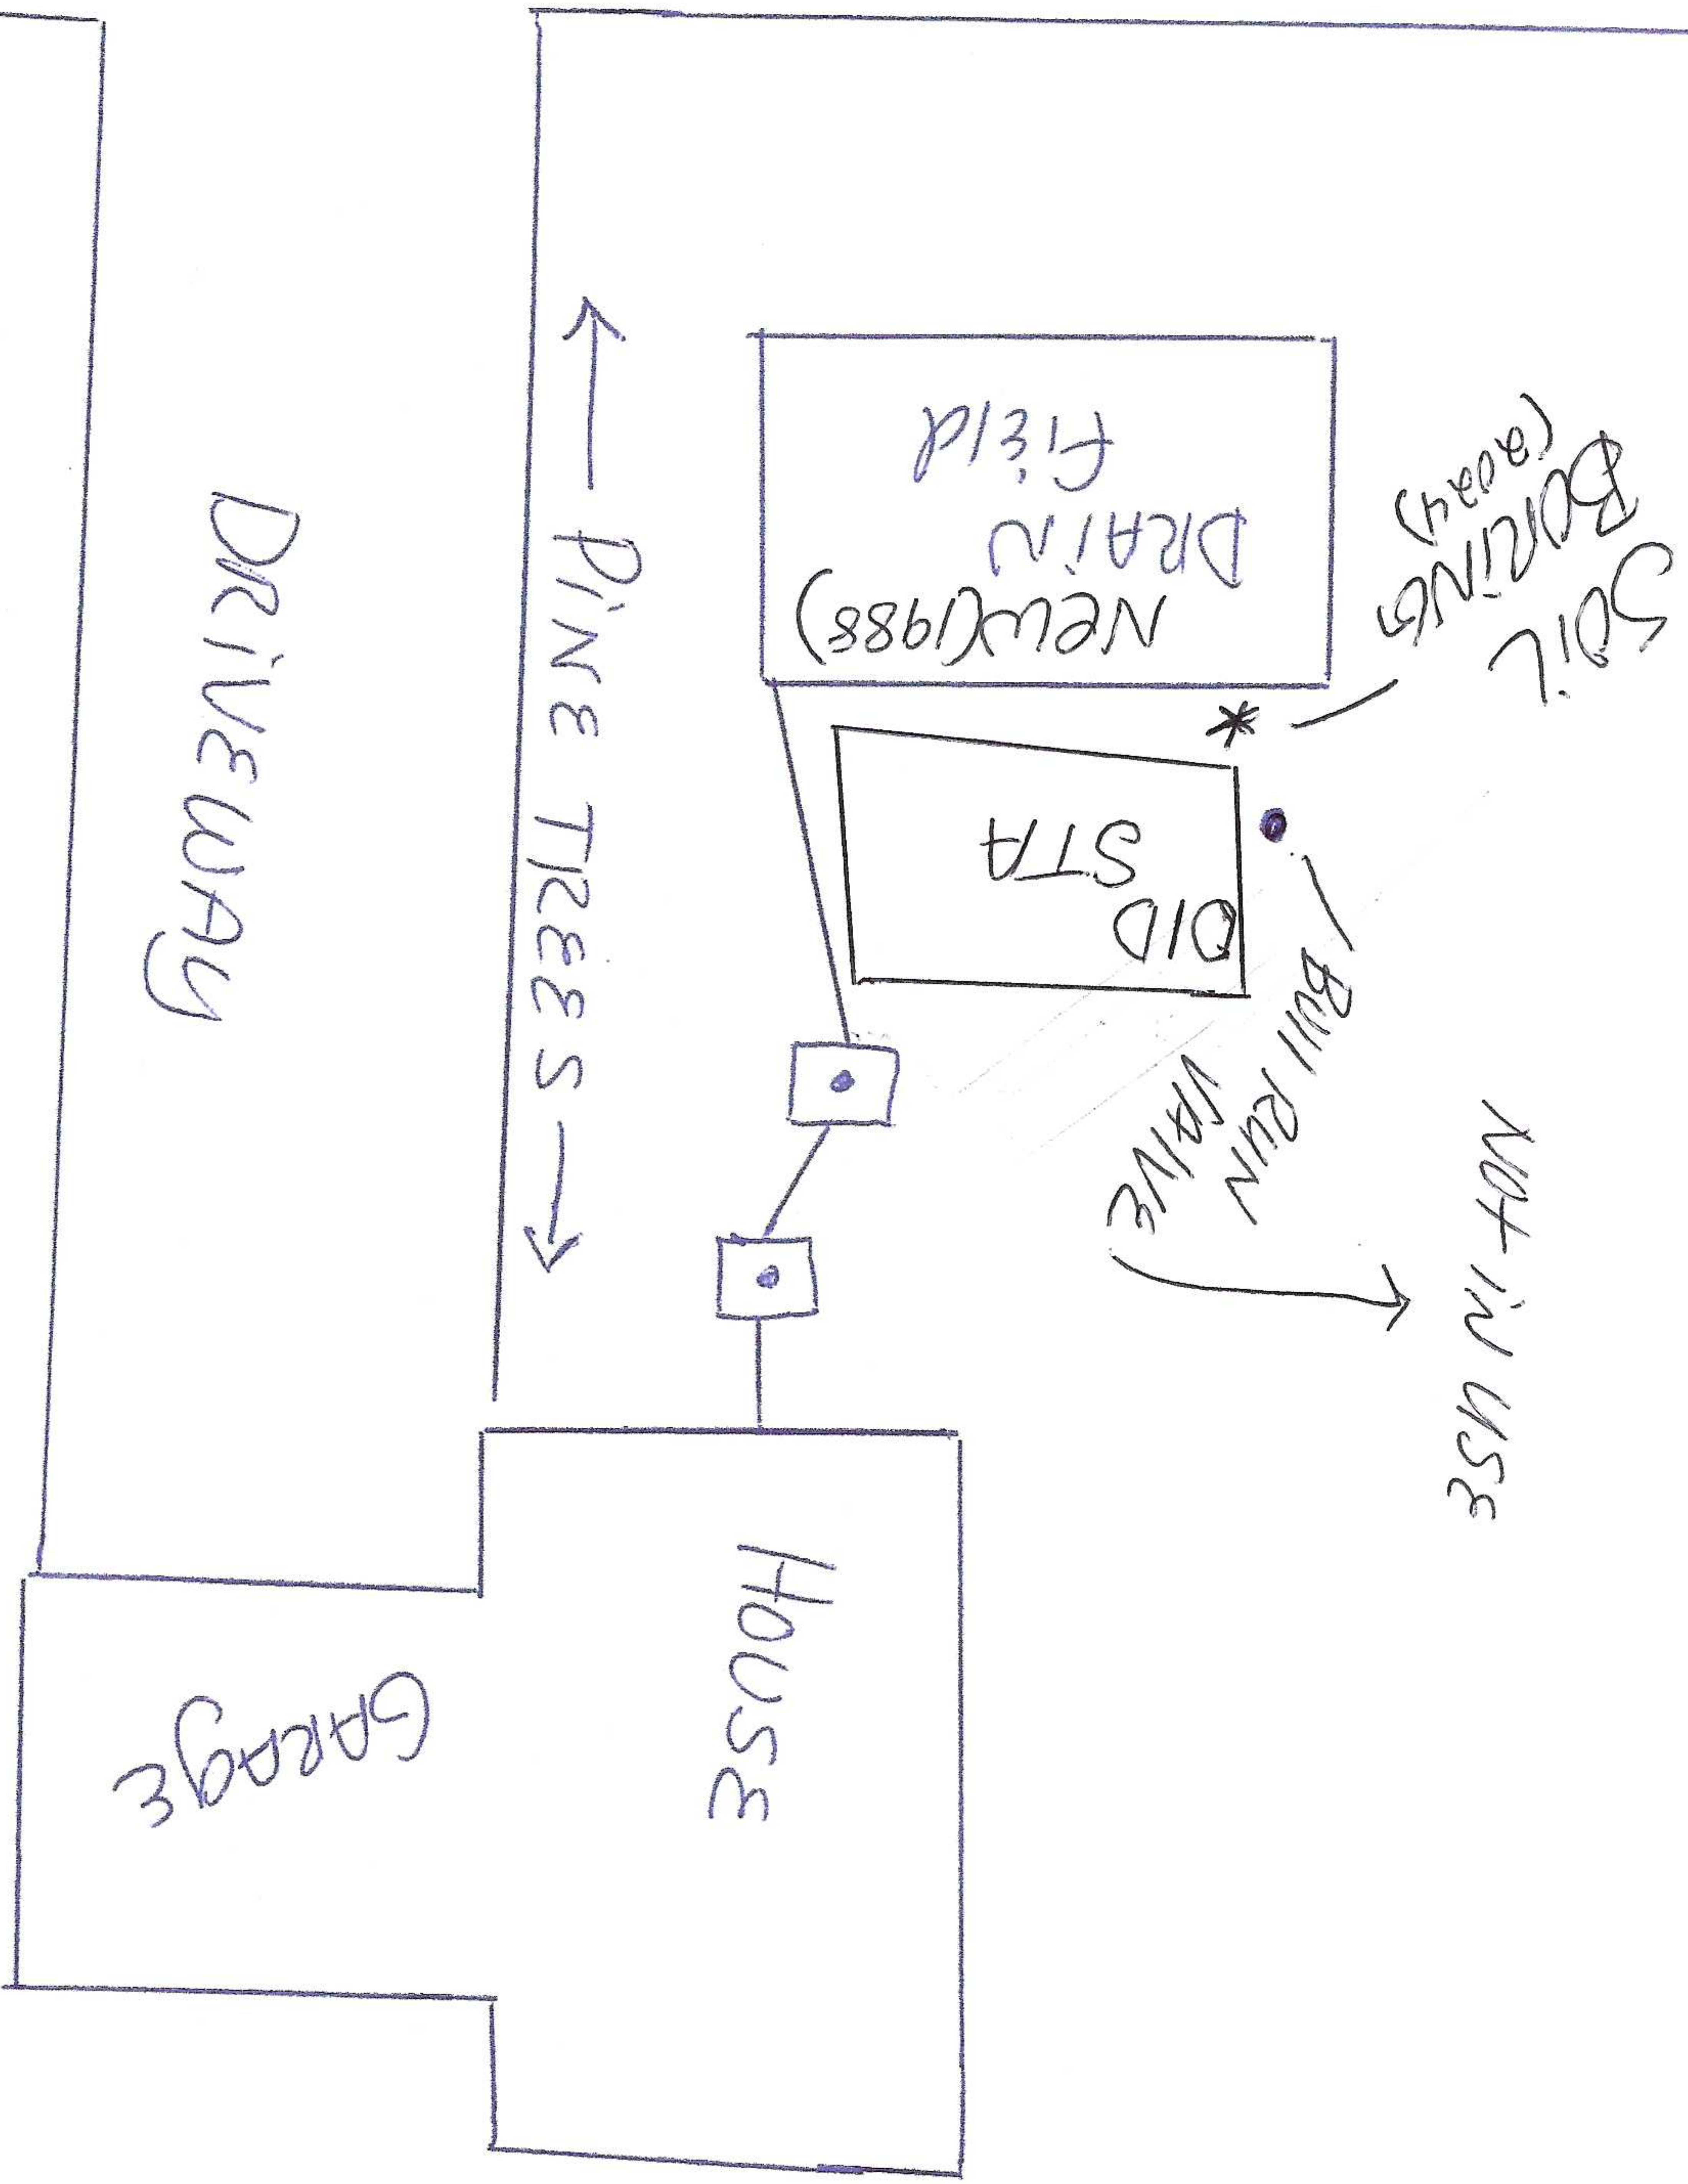

73 QUEHL AVE. S.  
LAKELAND



CITY WATER  
NO WELL