

\$20 Lainvette Road North \$1,79mil MN 55155-4194

Compliance Inspection Form

Existing Subsurface Sewage Treatment Systems (SSTS)

Doc Type: Compliance and Enforcement

Inspection results based on Minnesota Pollution Control Agency (MPCA) requirements and attached forms – additional local requirements may also apply.	For local tracking purposes:
Submit completed form to Local Unit of Government (LUG) and system owner within 15 days	
	· :
System Status	
System status on date (mm/dd/yyyy): 11/2/2016	
	bliant – Notice of Noncompliance e Requirements on page 3.)
Reason(s) for noncompliance (check all applicable)	
Impact on Public Health (Compliance Component #1) – Imminent threat to public h	nealth and safety
Other Compliance Conditions (Compliance Component #3) – Imminent the	The state of the s
☐ Tank Integrity (Compliance Component #2) – Failing to protect groundwa	
Soil Separation (Compliance Component #4) - Failing to protect groundw	-
Operating permit/monitoring plan requirements (Compliance Component)	· ·
Property Information Parcel ID# or Sec/Two/Ran	04 000 04 40 0040
	for inspection: routine
	phone: 651-775-4064
or -	
	ntative phone:
	ory authority phone: 651-430-6673
Brief system description: 2 1000 gallon septic tanks, 1000 gallon pump tank & mo	und drainfield.
Comments or recommendations:	:
The pump in the pump tank is functioning properly, but the alarm in the laundry room i	is not. Recommend repairing or replacing
ASAP.	
f_i^0	: :
	!
Certification	
I hereby certify that all the necessary information has been gathered to determine the determination of future system performance has been nor can be made due to unknow possible abuse of the system, inadequate maintenance, or future water usage.	compliance status of this system. No wn conditions during system construction,
	tion number: 323
	nse number: 1568
-7 7	
Inspector signature:Ph	one number: 612-594-4496
Necessary or Locally Required Attachments	
	local ordinance
Other information (list):	, : · · · · ·
* m ^e * #*	


	8	omedi, MN 55115	Inspector initials/Date: TT 11/2/2016 (mm/dd/yyyy)		
	mpact on Public Health—(Compliance compo	nent #1 of 5		
	Compliance criteria:		Verification method(s):		
S _ g	System discharges sewage to the round surface.	☐ Yes ⊠ No	Searched for surface outlet		
S ti	system discharges sewage to drain le or surface waters.	☐ Yes ☒ No	 Searched for seeping in yard/backup in home Excessive ponding in soil system/D-boxes 		
S	system causes sewage backup into welling or establishment.	☐ Yes ☒ No			
క	Any "yes" answer above indicates the system is an imminent threat to public health and safety.		☐ System requires "emergency" pumping ☐ Performed dye test ☐ Unable to verify (See Comments/Explanation)		
C	omments/Explanation:		Other methods not fisted (See Comments/Explanation)		
**j=*		·			
	ank Integrity — Compliance	component #2 of 5	. 1		
Sy ce	ompliance criteria: /stem consists of a seepage pit, esspool, drywell, or leaching pit.	☐ Yes ⊠ No	Verification method(s): ☑ Probed tank(s) bottom ☑ Examined construction records		
co.	pepage pits meeting 7080.2550 may be mpliant if allowed in local ordinance.		☐ Examined Tank Integrity Form (Attach)☐ Observed liquid level below operating depth		
de	ewage tank(s) leak below their signed operating depth. yes, which sewage tank(s) leaks:	☐ Yes ☒ No	☐ Examined empty (pumped) tanks(s) ☐ Probed outside tank(s) for "black soil"		
A	Any "yes" answer above indicates the system is failing to protect groundwater.		☐ Unable to verify (See Comments/Explanation) ☐ Other methods not listed (See Comments/Explanation)		
	omments/Explanation:				
Ot	her Compliance Conditions	5 – Compliance comp	onent #3 of 5		
a. b.	Maintenance hole covers are damag	jed, cracked, unsecured,	or appear to be structurally unsound. ☐ Yes* ☒ No ☐ Unknow		
-	Other issues (electrical hazards, etc.) to *System is an imminent threat to p Explain:	public health and safet	sely impact public health or safety. Yes* No Unknown		
c.	System is non-protective of ground w *System is failing to protect groun	/ater for other conditions	as determined by inspector . ☐ Yes* ☒ No		
	Explain:				
			;		

Property address: 730 Arcwood Rd, Mantome	di, MN 55115	Inspector initials/Date: _					
		•	(mm/dd/yyyy)				
4. Soil Separation - Compliance co	omponent #4 of 5						
Date of installation: 12/20/2003 (mm/dd/yyyy)	Unknown	Verification method(s):	V				
Shoreland/Wellhead protection/Food beverage lodging?	⊠Yes □ No	Soil observation does not expire. Previous soil observations by two independent parties are sufficient, unless site conditions have been altered or local					
Compliance criteria:		requirements differ.					
For systems built prior to April 1, 1996, and not located in Shoreland or Wellhead Protection Area or not serving a food,	☐ Yes ☐ No	 ☐ Conducted soil observation(s) (Attach boring logs) ☐ Two previous verifications (Attach boring logs) 					
beverage or lodging establishment:		Not applicable (Holding tank(s), no drainfield)					
Drainfield has at least a two-foot vertical separation distance from periodically saturated soil or bedrock.		☐ Unable to verify (See Comments/Explanation) ☐ Other (See Comments/Explanation)					
Non-performance systems built April 1,	⊠ Yes □ No	Comments/Explanation:					
1996, or later or for non-performance systems located in Shoreland or Wellhead		0-9 sandy loam topsoil	10 YR 3/2				
Protection Areas or serving a food,		9-30 sandy loam					
beverage, of lodging establishment:		30-48 sandy loam10 R 4/4					
Drainfield has a three-foot vertical separation distance from periodically		redox @ 30"					
saturated soil or bedrock.*	· · · · · · · · · · · · · · · · · · ·		. <u>†</u>				
"Experimental", "Other", or "Performance"	☐ Yes ☐ No	Indicate depths or elevations					
systems built under pre-2008 Rules; Type IV or V systems built under 2008 Rules (7080. 2350 or 7080.2400 (Advanced Inspector		A. Bottom of distribution media	mound with 1' sand				
License required)		B. Periodically saturated soil/bedrock	30"				
Drainfield meets the designed vertical separation distance from periodically		C. System separation	42"				
saturated soil or bedrock.		D. Required compliance separation*	36"				
Any "no" answer above indicates t	*May be reduced up to 15 percent if						
failing to protect groundwater.		Ordinance.					
i en							
 Operating Permit and Nitrogen 	BMP* – Complian	ce component #5 of 5 🛛 🔀 N	lot applicable				
is the system operated under an Operating		⊠ No If "yes", A below is requir	ed				
Is the system required to employ a Nitroger	n BMP? ☐ Yes	⊠ No If "yes", B below is requir	ed ;				
BMP = Best Management Practice(s) specified in the system design							
If the answer to both questions is "no", this section does not need to be completed.							
(1) (4)			4) a				
Compliance criteria			:				
Operating Permit number: <u>n/a</u> Have the Operating Permit requirement A second contents of the contents	nts heen met?	☐ Yes ☐ No					
		DVas DNa	\$				
b. Is the required nitrogen BMP in place and properly functioning?							
Upgrade Requirements (Minn. Stat. § 115.55)	An imminent threat to put	blic health and safety (ITPHS) must be upgi	raded, replaced, or its use				
discontinued within ten months of receipt of this ground water, the system must be upgraded, rep is not failing as defined in law, and has at least to its use discontinued, notwithstanding any local owner. Welihead Protection Areas, or those used in con	laced, or its use discontino vo feet of design soil sepa rdinance that is more strict	ued within the time required by local ordinal ration, then the system need not be upgrad t. This provision does not apply to systems i	nce. If an existing system led, repaired, replaced, or in shoreland areas.				

www.pca.state/mn.us • 651-296-6300 • 800-657-3864 • TTY 651-282-5332 or 800-657-3864 • Available in alternative formats wa-wwists4-31b • 6/4/14

@ N EXCAVATING INC 25614 GOODWIN AD WYOMING, MN 55088

Material Me I astalid & 1000 get agatus order 1-1000 get lift station 12-10-03 By G. M. Em Inc.

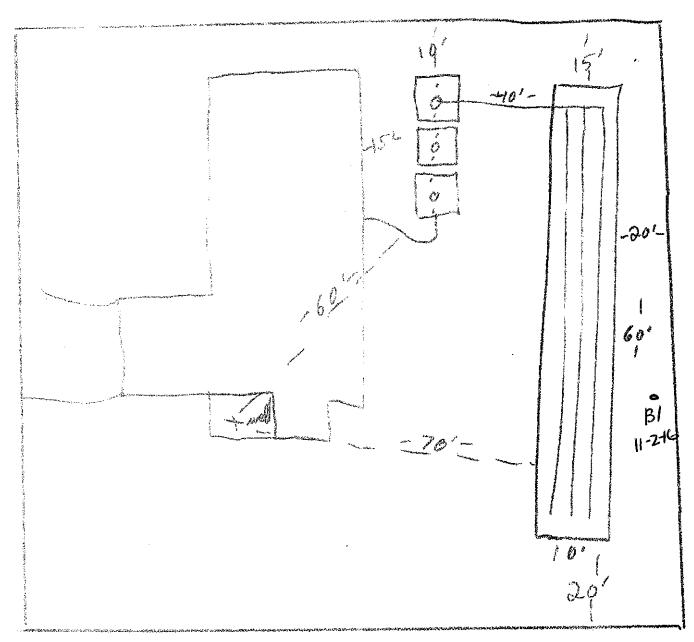

54