

wq-wwists4-31b • 6/4/14

520 Lafayette Road North St. Paul, MN 55155-4194

Compliance Inspection Form

Existing Subsurface Sewage Treatment Systems (SSTS)

Doc Type: Compliance and Enforcement

Inspection results based on Minnesota Pollution Control Agency (MPCA) requirements and attached forms – additional local requirements may also apply.	For local to	acking purposes:
Submit completed form to Local Unit of Government (LUG) and system owne within 15 days	er	
System Status		
System status on date (mm/dd/yyyy): 3/11/2017		
	mpliant – No rade Requiremen	otice of Noncompliance ots on page 3.)
Reason(s) for noncompliance (check all applicable)		
☐ Impact on Public Health (Compliance Component #1) – Imminent threat to publi ☐ Other Compliance Conditions (Compliance Component #3) – Imminent ☐ Tank Integrity (Compliance Component #2) – Failing to protect grounds ☐ Other Compliance Conditions (Compliance Component #3) – Failing to ☐ Soil Separation (Compliance Component #4) – Failing to protect grounds	t threat to public water protect groundy dwater	health and safety vater
Operating permit/monitoring plan requirements (Compliance Compone.	nt #5) – Noncom	pliant
Property owner: John Temperante Owne or Owner's representative: Repre	on for inspection: r's phone: _65^ esentative phone	property sale 1-260-2047
		hone 651-430-6673
Comments or recommendations:		
Certification		
hereby certify that all the necessary information has been gathered to determine the determination of future system performance has been nor can be made due to unknowssible abuse of the system, inadequate maintenance, or future water usage.	ne compliance st nown conditions (atus of this system. No during system construction,
managhan managa. Tana Tana b	cation number:	323
Business name: All State Septic Services LLC Lie	cense number:	1568
nenostar cignoture:	hone number:	11 (1)
Necessary or Locally Required Attachments		
	per local ordinand	7 . (1)
☐ Other information (list):	or reservicing	
		(0)
vww.pca.state.mn.us	or 800-657-3864 or 800-657-3864	 Available in alternative formats Available in alternative formats

			(mm/dd/yyyy)	
	pact on Public Health — Compliance criteria:	compliance component	ent #1 of 5 Verification method(s):	
			- Table 1	
	stem discharges sewage to the bund surface.	☐ Yes ☒ No	⊠ Searched for surface outlet	
		Dyac Mus	Searched for seeping in yard/backup in home Syspensive popular in cell water ⟨D bayes	
tile	stem discharges sewage to drain or surface waters.	Yes No	⊠ Excessive ponding in soil system/D-boxes	
Sy	stem causes sewage backup into elling or establishment.	☐ Yes ☒ No	☑ Homeowner testimony (<i>See Comments/Explanation</i>) ☐ "Black soil" above soil dispersal system	
	-		System requires "emergency" pumping	
	ny "yes" answer above indi		Performed dye test	
	rstem is an imminent threat ealth and safety.	to public	Unable to verify (See Comments/Explanation)	
		1.	☐ Other methods not listed (See Comments/Explanation)	
			295 486 486	
. Ta	nk Integrity – Compliance	component #2 of 5		
Co	mpliance criteria:		Verification method(s):	
Sv	stem consists of a seepage pit,	☐ Yes ☒ No	⊠ Probed tank(s) bottom	
	sspool, drywell, or leaching pit.		☑ Examined construction records	
See	epage pits meeting 7080.2550 may be		☐ Examined Tank Integrity Form (Attach)	
con	npliant if allowed in local ordinance.		☐ Observed liquid level below operating depth	
	wage tank(s) leak below their	☐ Yes ☒ No	☐ Examined empty (pumped) tanks(s)	
	signed operating depth. es, which sewage tank(s) leaks:		☐ Probed outside tank(s) for "black soil"	
		4 4	☐ Unable to verify (See Comments/Explanation)	
	ny "yes" answer above indi estem is failing to protect gi		☐ Other methods not listed (See Comments/Explanation)	
Co	mments/Explanation:			
. Ot	her Compliance Condition	NS — Compliance com	200ent #3 of 5	
			i, or appear to be structurally unsound. ☐ Yes* ☒ No ☐ Unknow	
a.		-		
 Other issues (electrical hazards, etc.) to immediately and adversely impact public health or safety. ☐ Yes* ☒ No ☐ *System is an imminent threat to public health and safety. 				
	Explain:		- 566° - 1566	
			4,570 L	
C.	System is non-protective of ground *System is failing to protect ground		s as determined by inspector . 🔲 Yes* 🛛 No	
	Explain:			
	state.mn.us • 651-296-6300 • state.mn.us • 651-296-6300 •		TY 651-282-5332 or 800-657-3864 • Available in alternative forms TY 651-282-5332 or 800-657-3864 • Available in alternative forms	

wq-wwists4-31b • 6/4/14

Property address: 6372 Crackleberry Trail

1846

Inspector initials/Date: TT | 3/11/2017

Property address: 6372 Crackleberry Trail	<u> </u>	Inspector initials/Date	
			(mm/dd/yyyy)
4. Soil Separation — Compliance co	ompopent #4 of 5		
	omponent #4 or 5		
Date of installation: 8/1/1988 (mm/dd/yyyy)	Unknown	Verification method(s):	•
Shoreland/Wellhead protection/Food beverage lodging?	☐ Yes ⊠ No	Soil observation does not expire observations by two independent unless site conditions have been	parties are sufficient,
Compliance criteria:		requirements differ.	3110100 01 10001
For systems built prior to April 1, 1996, and	⊠ Yes □ No	☑ Conducted soil observation(s)	(Attach boring logs)
not located in Shoreland or Wellhead Protection Area or not serving a food,		☐ Two previous verifications (Att	ach boring logs)
beverage or lodging establishment:		☐ Not applicable (Holding tank(s),	no drainfield)
Drainfield has at least a two-foot vertical		☐ Unable to verify (See Comment	s/Explanation)
separation distance from periodically saturated soil or bedrock.		Other (See Comments/Explanation	nn)
Non-performance systems built April 1,	☐ Yes ☐ No	Comments/Explanation:	
1996, or later or for non-performance systems located in Shoreland or Wellhead		0-7 top soil	7.5 YR 3/4
Protection Areas or serving a food,		8-31 silt loam	10 YR 3/4
beverage, or lodging establishment: Drainfield has a three-foot vertical		31-42 sandy clay loam	
separation distance from periodically		31-54 sandy loam	10 YR 5/3
saturated soil or bedrock.*		54-76 med sand	7.5 YR 4/6
		1. [1] [[[]]	
		1665	
"Experimental", "Other", or "Performance" ☐ Yes ☐ No		Indicate depths or elevation	; S
systems built under pre-2008 Rules; Type IV		· (1)	
or V systems built under 2008 Rules (7080. 2350 or 7080.2400 (Advanced Inspector		A. Bottom of distribution media	42-48
License required)		B. Periodically saturated soil/bedrock	
Drainfield meets the designed vertical	•	C. System separation	28"
separation distance from periodically saturated soil or bedrock.			,
	1 4 • •	D. Required compliance separation	tif allowed by Least
Any "no" answer above indicates t failing to protect groundwater.	ne system is	*May be reduced up to 15 percent Ordinance.	t if allowed by Local
ranning to protect groundwater.		A Property of the Control of the Con	
	_	The state of the s	
Operating Permit and Nitroger	n BMP* – Compliar	nce component #5 of 5	Not applicable
ls the system operated under an Operating	Permit?	s 🗵 No If "yes", A below is req	uired
Is the system required to employ a Nitroge	n BMP? 🔲 Yes	s 🗵 No 🏻 I f "yes", B below is req	uired
BMP = Best Management Practice(s)	specified in the system	design	
If the answer to both questions is "i	no", this section do	es not need to be completed.	
Compliance criteria			
a. Operating Permit number: n/a			
Have the Operating Permit requireme	ents been met?	☐ Yes ☐ No	
b. Is the required nitrogen BMP in place		ng? ☐ Yes ☐ No	
Any "no" answer indicates Nonc			

www.pca.state.mn.us www.pca.state.mn.us


651-296-6300 651-296-6300

800-657-3864 800-657-3864

TTY 651-282-5332 or 800-657-3864 TTY 651-282-5332 or 800-657-3864

Available in alternative formats
 Available in alternative formats
 Page 3 of 4

Upgrade Requirements (Minn. Stat. § 115.55) An imminent threat to public health and safety (ITPHS) must be upgraded, replaced, or its use discontinued within ten months of receipt of this notice or within a shorter period if required by local ordinance. If the system is failing to protect ground water, the system must be upgraded, replaced, or its use discontinued within the time required by local ordinance. If an existing system is not failing as defined in law, and has at least two feet of design soil separation, then the system need not be upgraded, repaired, replaced, or its use discontinued, notwithstanding any local ordinance that is more strict. This provision does not apply to systems in shoreland areas, Wellhead Protection Areas, or those used in connection with food, beverage, and lodging establishments as defined in law.

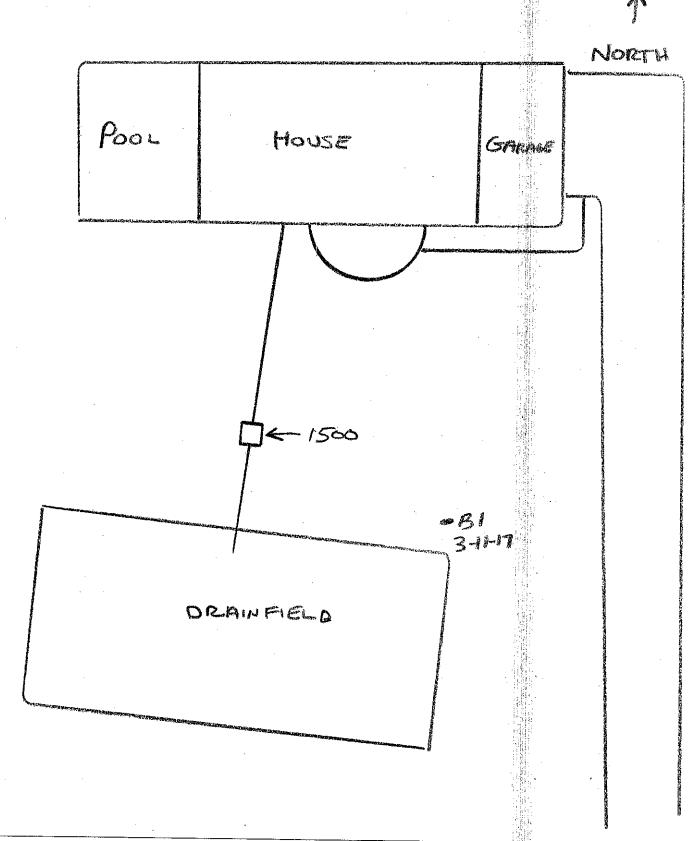

www.pca.state.mn.us www.pca.state.mn.us wq-wwists4-31b • 6/4/14 651-296-6300 651-296-6300

800-657-3864 800-657-3864

TTY 651-282-5332 or 800-657-3864 TTY 651-282-5332 or 800-657-3864

Available in alternative formats Available in alternative formats