

St. Paul, MN 55155-4194

Compliance Inspection Form

Existing Subsurface Sewage Treatment Systems (SSTS)

Doc Type: Compliance and Enforcement

Inspection results based on Minnesota Pollution Control Agency (MPCA)

For local tracking purposes:	

requirements and attached forms – additional local requirements m	
Submit completed form to Local Unit of Government (LUG) a within 15 days	nd system owner
System Status	
System status on date (mm/dd/yyyy): _5/3/2017	
Compliant − Certificate of Compliance (Valid for 3 years from report date, unless shorter time frame outlined in Local Ordinance.)	Noncompliant – Notice of Noncompliance (See Upgrade Requirements on page 3.)
Reason(s) for noncompliance (check all applicable) Impact on Public Health (Compliance Component #1) – Immin Other Compliance Conditions (Compliance Component Tank Integrity (Compliance Component #2) – Failing Other Compliance Conditions (Compliance Component Soil Separation (Compliance Component #4) – Failing Operating permit/monitoring plan requirements (Comp	nent threat to public health and safety ent #3) – Imminent threat to public health and safety to protect groundwater ent #3) – Failing to protect groundwater ng to protect groundwater
Property Information Parcel	I ID# or Sec/Twp/Range: 35.029.20.33.0065
Property address: 98 Quality Ave N Lakeland, MN 55043	Reason for inspection: _property sale_
Property owner: Gregory & Colleen Hayne	Owner's phone: 651-304-7876
or	Owner o priorie.
Owner's representative:	Representative phone:
Local regulatory authority: Washington County	Regulatory authority phone: 651-430-6673
Brief system description: 1500 gallon septic tank and 600 SF	of gravity, rock trench drainfield
Comments or recommendations:	
Tank was pumped on 5-3-17.	
Certification	
I hereby certify that all the necessary information has been gathed determination of future system performance has been nor can be possible abuse of the system, inadequate maintenance, or future	made due to unknown conditions during system construction,
Inspector name: _Tom Trooien	Certification number: 323
Business name: All State Septic Services LLC	License number: 1568
Inspector signature: 7on Troc	Phone number: 612-594-4496
Necessary or Locally Required Attachments	
	C Earma navional andianas
Soil boring logs System/As-built drawing ☐ Other information /list):	Forms per local ordinance
Other information (list):	

Co	ompliance criteria:		Verification method(s):	
	stem discharges sewage to the	☐ Yes ⊠ No	Searched for surface outlet	
Sys	ound surface. stem discharges sewage to drain or surface waters.	☐ Yes ☒ No	 ☑ Searched for seeping in yard/backup in home ☑ Excessive ponding in soil system/D-boxes ☑ Homeowner testimony (See Comments/Explanation) 	
Sy:	stem causes sewage backup into elling or establishment.	☐ Yes ⊠ No	☐ "Black soil" above soil dispersal system ☐ System requires "emergency" pumping	
Any "yes" answer above indicates the system is an imminent threat to public health and safety.			☐ Performed dye test ☐ Unable to verify (See Comments/Explanation) ☐ Other methods not listed (See Comments/Explanation)	
	mments/Explanation: ainfield is saturated.			
	nk Integrity - Compliance opposition of the compliance criteria:	component #2 of 5	Verification method(s):	
Sy	stem consists of a seepage pit, sspool, drywell, or leaching pit.	☐ Yes ⊠ No	 ☑ Probed tank(s) bottom ☑ Examined construction records 	
Sec	epage pits meeting 7080.2550 may be npliant if allowed in local ordinance.		☐ Examined Tank Integrity Form (Attach)	
	wage tank(s) leak below their signed operating depth.	☐ Yes No	☐ Observed liquid level below operating depth ☐ Examined empty (pumped) tanks(s)	
	ves, which sewage tank(s) leaks:		☐ Probed outside tank(s) for "black soil" ☐ Unable to verify (See Comments/Explanation)	
Any "yes" answer above indicates the system is failing to protect groundwater.			☐ Other methods not listed (See Comments/Explanation	
	mments/Explanation: :her Compliance Condition	ns – Compliance com	ponent #3 of 5	
a.	Maintenance hole covers are dama	aged, cracked, unsecure	d, or appear to be structurally unsound. ☐ Yes* ☒ No ☐ Unkn	
b.	Other issues (electrical hazards, etc.) to immediately and adversely impact public health or safety. Yes* No Unknows System is an imminent threat to public health and safety.			
	Explain:			
	System is non-protective of ground water for other conditions as determined by inspector . Yes* No *System is failing to protect groundwater.			
c.	· · · · · · · · · · · · · · · · · · ·	undwater.		


Inspector initials/Date: TT | 5/3/2017

TTY 651-282-5332 or 800-657-3864 • Available in alternative formats 651-296-6300 • www.pca.state.mn.us • 800-657-3864 wq-wwists4-31b • 6/4/14 Page 2 of 3

Property address: 98 Quality Ave N Lakeland, MN 55043

Property address. 96 Quality Ave N Lakeland		Inspector initials/Date:	(mm/dd/yyyy)	
4. Soil Separation - Compliance co	omponent #4 of	5		
Date of installation: 8/3/1992	Unknown	Verification method(s):		
(mm/dd/yyyy) Shoreland/Wellhead protection/Food beverage lodging?	☐ Yes No	Soil observation does not expire. Previous soil observations by two independent parties are sufficient, unless site conditions have been altered or local		
Compliance criteria:		requirements differ.	itered or local	
For systems built prior to April 1, 1996, and	⊠ Yes □ No	Conducted soil observation(s) (Attach boring logs)	
not located in Shoreland or Wellhead		☐ Two previous verifications (Attac		
Protection Area or not serving a food, beverage or lodging establishment:		☐ Not applicable (Holding tank(s), no drainfield)		
Drainfield has at least a two-foot vertical		Unable to verify (See Comments/Explanation)		
separation distance from periodically		☐ Other (See Comments/Explanation	<u> </u>	
saturated soil or bedrock.		-	,	
Non-performance systems built April 1,	☐ Yes ☐ No	Comments/Explanation:		
1996, or later or for non-performance systems located in Shoreland or Wellhead		B-1 0-20 sandy topsoil	B-1 0-20 sandy topsoil7.5 YR 2.5/2	
Protection Areas or serving a food,		20-36 med/course sand	10 YR YR 3/3	
beverage, or lodging establishment:		36-72 med sand	7.5 YR 4/4	
Drainfield has a three-foot vertical separation distance from periodically		B2 0-24 sandy topsoil	10 YR 2/2	
saturated soil or bedrock.*		24-40 med/course san		
		40-72 sand		
"Experimental", "Other", or "Performance"	☐ Yes ☐ No	Indicate depths or elevations		
systems built under pre-2008 Rules; Type IV				
or V systems built under 2008 Rules (7080. 2350 or 7080.2400 (Advanced Inspector		A. Bottom of distribution media	18-24	
License required)		_B. Periodically saturated soil/bedrock		
Drainfield meets the designed vertical		C. System separation	48	
separation distance from periodically saturated soil or bedrock.		O. Gystem separation	40	
	-	D. Required compliance separation*	24	
Any "no" answer above indicates t failing to protect groundwater. 5. Operating Permit and Nitroger	•	*May be reduced up to 15 percent Ordinance.	·	
5. Operating Permit and Nitroger			Not applicable	
Is the system operated under an Operating	_	Yes No If "yes", A below is requ	ired	
Is the system required to employ a Nitroge	n BMP?	Yes No If "yes", B below is requ	ired	
BMP = Best Management Practice(s)	specified in the sys	tem design		
If the answer to both questions is "r	o", this section	does not need to be completed.		
		•		
Compliance criteria				
a. Operating Permit number: <u>n/a</u>		☐ Yes ☐ No		
Have the Operating Permit requirement				
b. Is the required nitrogen BMP in place and properly functioning? Yes No				
Any "no" answer indicates Nonc	ompliance.			
Upgrade Requirements (Minn. Stat. § 115.55 discontinued within ten months of receipt of this ground water, the system must be upgraded, regis not failing as defined in law, and has at least tits use discontinued, notwithstanding any local of Wellhead Protection Areas, or those used in continued.	notice or within a sho placed, or its use disc wo feet of design soil rdinance that is more	rter period if required by local ordinance. If the ontinued within the time required by local ordin separation, then the system need not be upgra strict. This provision does not apply to system.	system is failing to protect ance. If an existing system aded, repaired, replaced, or s in shoreland areas.	

651-296-6300 • 800-657-3864 • TTY 651-282-5332 or 800-657-3864 • Available in alternative formats www.pca.state.mn.us • wq-wwists4-31b • 6/4/14 Page 3 of 3

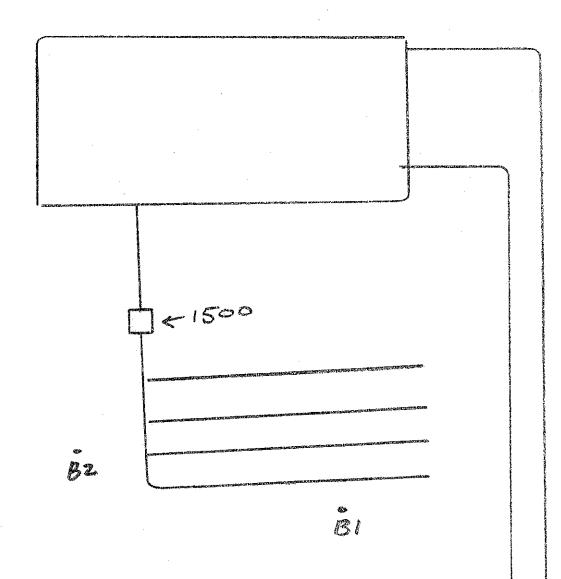

98 QUALITY AVE. N

NO WELL & ITYWATER